

RECEIVED
STATE CORPORATION COMMISSION
5-4-82
MAY - 4 1982
CONSERVATION DIVISION
Wichita, Kansas

WELL PLUGGING RECORD

STATE OF KANSAS STATE CORPORATION COMMISSION


Give All Information Completely
Make Required Affidavit
Mail or Deliver Report to:
Conservation Division
State Corporation Commission
212 No. Market
Wichita, Kansas 67202

Graham County, Sec. 28 Twp. 9S Rge. 25W (E) (W) line

Location as "NE/CNW/ESW" or footage from lines 660' from W line, 660' from NE 1/4

Lease Owner: Energy Production, Inc.
Lease Name: Sauer Well No. 1
Office Address: Suite 150- 8020 East Central - Wichita, Kansas 67206
Character of Well (completed as Oil, Gas or Dry Hole) Oil
Date well completed February 11, 1967
Application for plugging filed December 29, 1981
Application for plugging approved January 1982
Plugging commenced April 9, 1982
Plugging completed April 10, 1982
Reason for abandonment of well or producing formation Ceased Producing

If a producing well is abandoned, date of last production July 1981
Was permission obtained from the Conservation Division or its agents before plugging was commenced? Yes

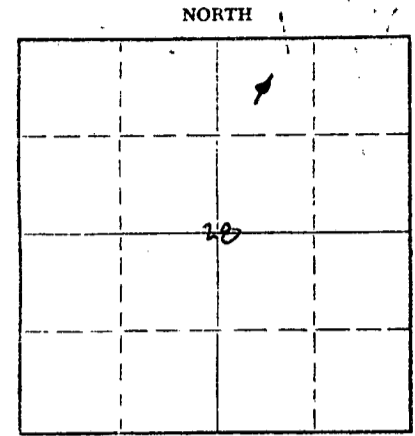

Locate well correctly on above Section Plat

Name of Conservation Agent who supervised plugging of this well Dennis Hammell
Producing formation L - KC Depth to top 3895 Bottom 4078 Total Depth of Well 4100 Feet
Show depth and thickness of all water, oil and gas formations.

OIL, GAS OR WATER RECORDS CASING RECORD

FORMATION	CONTENT	FROM	TO	SIZE	PUT IN	PULLED OUT
				8-5/8	210	None
				5 1/2	4397'	None

Describe in detail the manner in which the well was plugged, indicating where the mud fluid was placed and the method or methods used in introducing it into the hole. If cement or other plugs were used, state the character of same and depth placed, from feet to feet for each plug set.

Plugged by pump truck - Allied Cementing Co. - Russell, Ks. - Pump 3 sacks hulls and 75 sacks cement 50/50 Pozmix - 6% jell - 3% Chloride - Space with 16 sacks Jell - release plug - Pump 225 sacks 50/50 pozmix cement - 6% jell - 3% Chloride - No pressure - shut in - 4/10/82 - Run measuring line - cement @ 250-300' - Allied plugged to surface with 75 sacks 50/50 Pozmix cement - Job complete 4-28-82 - Dig out cellar - cut off surface casing 4' below ground level.

(If additional description is necessary, use BACK of this sheet)

Name of Plugging Contractor Allied Cementing Co. - Russell, Kansas
Address

STATE OF KANSAS, COUNTY OF SEDGWICK, ss. James M. Stewart (employee of owner) or (owner or operator) of the above-described well.

being first duly sworn on oath, says: That I have knowledge of the facts, statements, and matters herein contained and the log of the above-described well as filed and that the same are true and correct. So help me God.

(Signature) *James M. Stewart*
8020 E. Central, #150, Wichita, KS 67206 (Address)

SUBSCRIBED AND SWORN to before me this 29th day of April, 1982

Thomas H. Stewart
Thomas H. Stewart Notary Public

My commission expires October 27, 1985
THOMAS H. STEWART
NOTARY PUBLIC
STATE OF KANSAS
My Appt. Exp. 10-27-85

Gabbert-Jones, Inc.
Wichita, Kansas
Drillers' Well Log

Sauer #1
C NW NE Section 28-9S-25W
Graham County, Kansas

Commenced: January 16, 1967
Completed: January 29, 1967

OPERATOR - James M. Stewart

DEPTH		FORMATION	REMARKS
From	To		
0	80	Surface clay and sand	
80	210	Shale	Ran 10 joints of 8-5/8" casing set @ 210' w/150 sacks cement.
210	1410	Shale	
1410	1500	Sand	
1500	1695	Shale	
1695	1985	Sand	
1985	2200	Shale	
2200	2235	Anhydrite	
2235	2260	Shale and shells	
2260	2625	Shale	
2625	3185	Lime and shale	
3185	3285	Lime	
3285	3660	Lime and shale	
3660	3777	Lime	
3777	3839	Lime and shale	
3839	4069	Lime	
4069	4100	Lime	
4100	TD		Ran 131 joints of 5-1/2" casing set @ 4097' w/125 sacks cement. DV tool @ 2236' w/175 sacks cement.

I, E. E. HALL, certify this is a correct copy of the Drillers' Log for the well drilled in the C NW NE Section 28-9S-25W, Graham County, Kansas, to the best of my knowledge and belief.

E. E. Hall
E. E. HALL

STATE OF KANSAS)
)SS
COUNTY OF SEDGWICK)

Before me, the undersigned, a Notary Public within and for said County and State, on this 31st day of January, 1967, personally appeared E. E. HALL, to me personally known to be the identical person who executed the within and foregoing instrument and acknowledged to me that he executed the same as his free and voluntary act and deed for the uses and purposes therein set forth.

IN WITNESS WHEREOF, I have hereunto set my hand and official seal the day and year last above written.

Barbara J. Linton
Barbara J. Linton, Notary Public
STATE CORPORATION COMMISSIONER

My Commission Expires February 1, 1968.

DEC 30 1967
CONSERVATION DIVISION
Wichita, Kansas