

STATE OF KANSAS  
STATE CORPORATION COMMISSION


WELL PLUGGING RECORD

Give All Information Completely  
Make Required Affidavit  
Mail or Deliver Report to  
Conservation Division  
State Corporation Comm.  
245 North Water  
Wichita, KS 67202

Graham County, Sec. 28 Twp. 9 Rge. 25 X/W  
Location as "NE/CNW 1/4 SW 1/4" or footage from lines  
SW SE NW

Lease Owner Condor Oil Co.  
Lease Name Rohleder Well No. 1  
Office Address% Joe Jeter, First Natl. Bank, Hays, KS 67601  
Character of Well (Completed as Oil, Gas or Dry Hole) Dry Hole

Date Well completed 5-26 1982  
Application for plugging filed 5-26 1982  
Application for plugging approved 5-26 1982  
Plugging commenced 5-26 1982  
Plugging completed 5-26 1982  
Reason for abandonment of well or producing formation

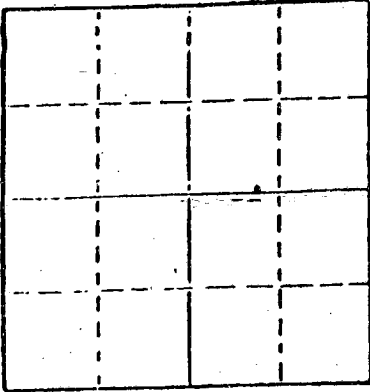

Locate well correctly on above  
Section Plot

If a producing well is abandoned, date of last production 19

Was permission obtained from the Conservation Division or  
its agents before plugging was commenced? Yes

Name of Conservation Agent who supervised plugging of this well Carl Goodrow  
Producing formation Depth to top Bottom Total Depth of Well 4100'  
Show depth and thickness of all water, oil and gas formations.

OIL, GAS OR WATER RECORDS

CASING RECORD

FORMATION	CONTENT	FROM	TO	SIZE	PUT IN	PULLED OUT
				8 5/8"	258'	-0-

Describe in detail the manner in which the well was plugged, indicating where the mud fluid  
was placed and the method or methods used in introducing it into the hold. If cement or other  
plugs were used, state the character of same and depth placed, from feet to  
feet for each plug set.

1st plug was set at 1260' with 70 sacks cement  
2nd plug was set at 280' with 40 sacks cement  
3rd plug was set at 40' with 10 sacks cement

(If additional description is necessary, use BACK of this sheet)


Name of Plugging Contractor Dreiling Oil, Inc.

STATE OF KANSAS COUNTY OF ELLIS, ss.  
JOSEPH W. JETER (employee of owner) or (owner or operator)  
of the above-described well, being first duly sworn on oath, says: That I have knowledge of  
the facts, statements, and matters herein contained and the log of the above-described well  
as filed and that the same are true and correct. So help me God.

(Signature)

P. O. Box 128, Hays, KS 67601  
(Address)

SUBSCRIBED AND SWORN TO before me this 8th day of June, 1982

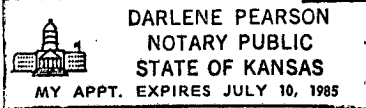

Darlene Pearson  
Notary Public.

My commission expires

RECEIVED  
STATE CORPORATION COMMISSION  
6-9-82  
JUN - 9 1982  
CONSERVATION DIVISION  
Wichita, Kansas

RECEIVED  
STATE CORPORATION COMMISSION  
AUG 17 1983  
CONSERVATION DIVISION  
Wichita, Kansas