

15-065-00645-0000

STATE OF KANSAS
STATE CORPORATION COMMISSION


Give All Information Completely
Make Required Affidavit
Mail or Deliver Report to:
Conservation Division
State Corporation Commission
211 No. Broadway
Wichita, Kansas

WELL PLUGGING RECORD

Graham County. Sec. 32 Twp. 9S Rge. 25 (~~EXX~~) (W)

Location as "NE/CNW%SW%" or footage from lines. NW NW SW
Lease Owner Anderson-Prichard Oil Corp.
Lease Name Brungardt Unit Well No. 1
Office Address Box 142, Great Bend, Kansas
Character of Well (completed as Oil, Gas or Dry Hole) Dry hole
Date well completed Sept. 11, 19 60
Application for plugging filed Sept. 11, 19 60
Application for plugging approved Sept. 11, 19 60
Plugging commenced Sept. 11, 19 60
Plugging completed Sept. 11, 19 60
Reason for abandonment of well or producing formation Dry hole

NORTH

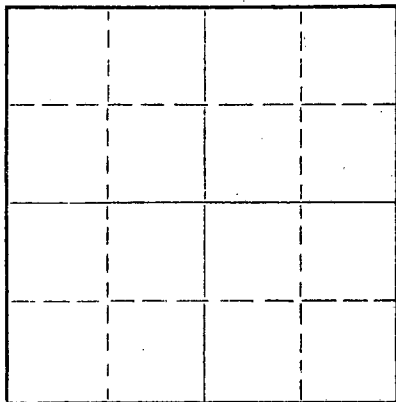

Locate well correctly on above
Section Plat

If a producing well is abandoned, date of last production _____ 19____
Was permission obtained from the Conservation Division or its agents before plugging was commenced? Yes

Name of Conservation Agent who supervised plugging of this well A. D. Fabricius
Producing formation _____ Depth to top _____ Bottom _____ Total Depth of Well 4371 Feet
Show depth and thickness of all water, oil and gas formations.

OIL, GAS OR WATER RECORDS

CASING RECORD

FORMATION	CONTENT	FROM	TO	SIZE	PUT IN	PULLED OUT
				8 5/8	218'	None

Describe in detail the manner in which the well was plugged, indicating where the mud fluid was placed and the method or methods used in introducing it into the hole. If cement or other plugs were used, state the character of same and depth placed, from _____ feet to _____ feet for each plug set.

TD 4371 to 400' Heavy mud
400' to 220' plug, 20 sx cement and heavy mud
220' to 40' plug, 20 sx cement and heavy mud
40' to surface plug and 10 sx cement to surface

RECEIVED
STATE CORPORATION COMMISSION
10-6-60
OCT 6 1960

CONSERVATION DIVISION
Wichita, Kansas

(If additional description is necessary, use BACK of this sheet)

Name of Plugging Contractor Kimbark Exploration Co.
Address 201 University Blvd., Denver, Colorado

STATE OF Kansas, COUNTY OF Barton, ss.
Gerald M. Dougherty (employee of owner) or (~~owner or operator~~) of the above-described well, being first duly sworn on oath, says: That I have knowledge of the facts, statements, and matters herein contained and the log of the above-described well as filed and that the same are true and correct. So help me God.

(Signature) Gerald M. Dougherty
Box 142, Great Bend, Kansas
(Address)

SUBSCRIBED AND SWORN to before me this 5th day of October, 19 60

Verdella M. Hankins
Notary Public.

Dec. 4, 1962



BRUNGARDT UNIT #1 WELL

Location: NW NW SW Sec. 32
T-9-S, R-25-W
Graham Co., Kansas

Spudded: 8/28/60
Completed: 9/11/60

Owner: Anderson-Prichard Oil Corp.
314 Orpheum Building
Wichita, Kansas

Contractor: Kimbark Exploration Co.
201 University Blvd.
Denver 6, Colorado

Surface Casing: 8 5/8" ss casing cemented @ 218' K.B. w/175 sxs.

Oil String: 4 1/2", 9 1/2", J-55 set @ 4001' and cemented w/100 sxs.

LOG - Figures indicate bottom of formation.

650	Shale
2,050	Shale & Sand
2,430	Shale
2,862	Shale & Lime
3,205	Shale & Lime
3,459	Shale & Lime
3,735	Shale & Lime
3,810	Lime & Shale
3,910	Lime & Shale
4,020	Lime
4,192	Shale & Lime
4,370	Shale & Lime
4,372	Rotary Total Depth

The undersigned, W. K. Arbuckle, President of Kimbark Exploration Company, hereby certified that the above is a true and correct log of the formations encountered in drilling the Brungardt Unit #1 as shown in the daily drilling reports.

KIMBARK EXPLORATION COMPANY
W. K. Arbuckle
W. K. Arbuckle, President

STATE OF COLORADO)ss
CITY & COUNTY OF DENVER)

Be it remembered that on the 29th day of September, 1960, before me, a notary public, personally appeared W. K. Arbuckle, Pres. of Kimbark Exploration Company, a Colorado Corporation, who is personally known to me and known to me to be the President of said Corporation, and the same person who executed the foregoing instrument, and he has duly acknowledged the execution of the same for and on behalf of and as the act and deed of said corporation.

WITNESS my hand and official seal:
My commission Expires My Commission expires August 20, 1964

RECEIVED
STATE CORPORATION COMMISSION
OCT 6 1960
CONSERVATION DIVISION
Wichita, Kansas

