

15-065-20385-0000

STATE OF KANSAS
STATE CORPORATION COMMISSION


Form CP-4

Give All Information Completely
Make Required Affidavit
Mail or Deliver Report to:
Conservation Division
State Corporation Commission
212 No. Market
Wichita, Kansas 67202

WELL PLUGGING RECORD

Graham County. Sec. 32 Twp. 9S Rge. (E)25 (W)
Location as "NE/CNWxSWx" or footage from lines. SW NW NW
Lease Owner Abercrombie Drilling, Inc.
Lease Name Pfeifer Well No. 1
Office Address 801 Union Center, Wichita, Kansas 67202
Character of Well (completed as Oil, Gas or Dry Hole) Dry Hole
Date well completed October 22, 19 70
Application for plugging filed (verbally) October 22, 19 70
Application for plugging approved (verbally) October 22, 19 70
Plugging commenced October 22, 19 70
Plugging completed October 22, 19 70
Reason for abandonment of well or producing formation Dry Hole

NORTH

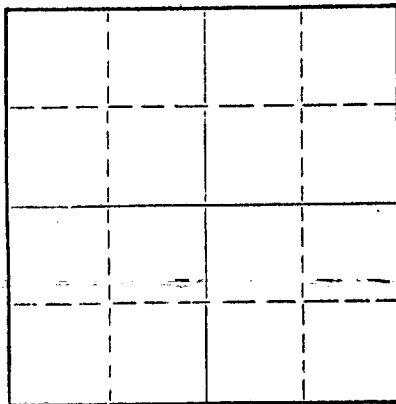

Locate well correctly on above
Section Plat

If a producing well is abandoned, date of last production 19
Was permission obtained from the Conservation Division or its agents before plugging was commenced? Yes

Name of Conservation Agent who supervised plugging of this well: W. L. Nichols
Producing formation _____ Depth to top _____ Bottom _____ Total Depth of Well 4090 Feet
Show depth and thickness of all water, oil and gas formations.

OIL, GAS OR WATER RECORDS

CASING RECORD

FORMATION	CONTENT	FROM	TO	SIZE	PUT IN	PULLED OUT
				8 5/8"	218'	None

Describe in detail the manner in which the well was plugged, indicating where the mud fluid was placed and the method or methods used in introducing it into the hole. If cement or other plugs were used, state the character of same and depth placed, from _____ feet to _____ feet for each plug set.

Set 1st plug @1325' w/65 sx. cement
Set 2nd plug @ 220' w/20 sx. cement
Set top plug @ 40' w/10 sx. cement
Job was completed at 5:00 p.m. 10-22-70.

RECEIVED
STATE CORPORATION COMMISSION
10-28-70
OCT 28 1970
CONSERVATION DIVISION
Wichita, Kansas

(If additional description is necessary, use BACK of this sheet)
Name of Plugging Contractor Abercrombie Drilling, Inc.
Address 801 Union Center, Wichita, Kansas 67202


STATE OF KANSAS, COUNTY OF SEDGWICK, ss.
Jerry A. Langrehr (employee of owner) or (owner or operator) of the above-described well, being first duly sworn on oath, says: That I have knowledge of the facts, statements, and matters herein contained and the log of the above-described well as filed and that the same are true and correct. So help me God.

(Signature) Jerry A. Langrehr
801 Union Center, Wichita, Kansas 67202
(Address)

SUBSCRIBED AND SWORN TO before me this 27th day of October, 1970

November 12, 1973

Sue J. McCoy
Sue J. McCoy Notary Public.

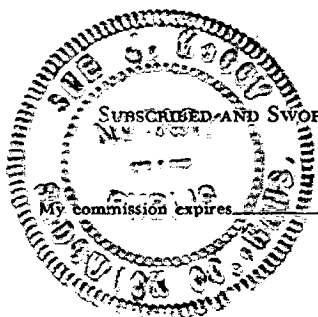

CONTRACTOR'S WELL LOG

OPERATOR:	Abercrombie Drilling, Inc.
CONTRACTOR:	Abercrombie Drilling, Inc.
WELL NAME:	PFEIFER #1
LOCATION:	SW NW NW, Sec. 32-9S-25W Graham County, Kansas
GEOLOGIST:	Jack K. Wharton
SPUD DATE:	October 14, 1970
COMPLETION DATE:	October 22, 1970

0	115	Clay
115	140	Sand & Flint
140	1475	Shale
1475	1650	Sand
1650	1838	Shale
1838	2018	Sand
2018	2243	Shale
2243	2280	Anhydrite
2280	2760	Shale
2760	3204	Shale & Lime
3204	3339	Lime & Shale
3339	3400	Shale & Lime
3400	3800	Lime & Shale
3800	3955	Lime
3955	3980	Lime & Shale
3980	4090	Lime
	4090	Rotary Total Depth

RECEIVED
STATE CORPORATION COMMISSION
OCT 28 1970
CONSERVATION DIVISION
Wichita, Kansas

Drilled 221' of 12½" hole; set 8 5/8" surface @218' w/175 sx. cement. Cement circulated. Plug was down at 2:30 p.m. 10-14-70.
Dry and Abandoned

<u>SAMPLE TOPS</u>	<u>ELEVATION</u>
Anhydrite 2243 (+354)	2597 K.B.
B/Anhydrite 2280 (+317)	2595 D.F.
Topeka 3622 (-1025)	2589 G.L.
Heebner 3840 (-1243)	
Toronto 3862 (-1265)	
Lansing 3878 (-1281)	

STATE OF KANSAS)
) SS
COUNTY OF SEDGWICK)

Jerry A. Langrehr, President of Abercrombie Drilling, Inc., does hereby state that the above and foregoing is a true and correct copy of the log of the PFEIFER #1, SW NW NW, Sec. 32-9S-25W, Graham County, Kansas.

ABERCROMBIE DRILLING, INC.

By: Jerry A. Langrehr
Jerry A. Langrehr
President

Subscribed and sworn to before me, a Notary Public, in and for the aforesaid county and state as of this 27th day of October, 1970.

Sue J. McCoy
Sue J. McCoy, Notary Public

My Commission Expires:

November 12, 1973

