


STATE OF KANSAS
STATE CORPORATION COMMISSION

WELL PLUGGING RECORD

Give All Information Completely
Make Required Affidavit
Mail or Deliver Report to
Conservation Division
State Corporation Comm.
245 North Water
Wichita, KS 67202

Graham County, Sec. 32 Twp. 9 S Rge. 25 E/W
Location as "NE/CNW $\frac{1}{2}$ SW $\frac{1}{2}$ " or footage from lines
SW NE SW

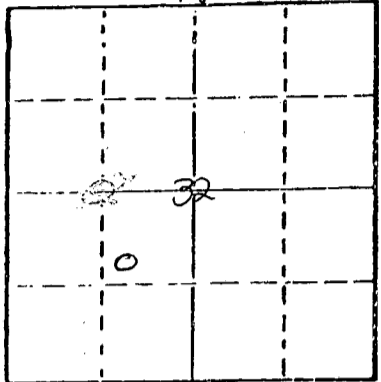

Locate well correctly on above
Section Plat

Lease Owner D/FW Oil & Gas, Inc.
Lease Name Jacobs Well No. 1
Office Address Suite 403 Expressway Towers, 6116 N. Central
Character of Well (Completed as Oil, Gas or Dry Hole) Dry Hole
Expressway, Dallas, Tx. 75206

Date Well completed July 20, 1978
Application for plugging filed (verbally) July 20, 1978
Application for plugging approved (verbally) July 20, 1978
Plugging commenced July 20, 1978
Plugging completed July 20, 1978

Reason for abandonment of well or producing formation
No commercial quantity of oil or gas encountered
If a producing well is abandoned, date of last production
19

Was permission obtained from the Conservation Division or
its agents before plugging was commenced? Yes

Name of Conservation Agent who supervised plugging of this well Gilbert Balthazor
Producing formation _____ Depth to top _____ Bottom _____ Total Depth of Well 4315'
Show depth and thickness of all water, oil and gas formations.

OIL, GAS OR WATER RECORDS

CASING RECORD

FORMATION	CONTENT	FROM	TO	SIZE	PUT IN	PULLED OUT

Describe in detail the manner in which the well was plugged, indicating where the mud fluid
was placed and the method or methods used in introducing it into the hold. If cement or other
plugs were used, state the character of same and depth placed, from _____ feet to
_____ feet for each plug set.

Set 1st plug at 1150' with 70 sacks
2nd plug at 200' with 20 sacks
3rd plug at 40' - solid bridge - with 10 sacks
Cemented with Sun Cement

RECEIVED
STATE CORPORATION COMMISSION
7-25-78
JUL 25 1978
CONSERVATION DIVISION
Wichita, Kansas

(If additional description is necessary, use BACK of this sheet)

Name of Plugging Contractor Abercrombie Drilling, Inc.

STATE OF KANSAS COUNTY OF SEDGWICK, ss.
Jerry A. Langrehr, Exec. Vice President (employee of owner) or (owner or operator)
of the above-described well, being first duly sworn on oath, says: That I have knowledge of
the facts, statements, and matters herein contained and the log of the above-described well
as filed and that the same are true and correct. So help me God.

(Signature) Jerry A. Langrehr
807 Union Center, Wichita, Kansas 67202
(Address)

AND SWORN TO before me this 24th day of July, 1978



Sandra Richman
Sandra Richman Notary Public.

OPERATOR:
CONTRACTOR:
WELL NAME:
LOCATION:

SPUD DATE:
COMPLETION DATE:

D/FW Oil & Gas, Inc.
Abercrombie Drilling, Inc.
Jacobs #1
SW NE SW, Section 32-9S-25W
Graham County, Kansas
July 11, 1978
July 20, 1978.

0	215	Surface soil, sand & shale
215	1175	Shale
1175	2226	Shale & sand
2226	2258	Anhydrite
2258	2359	Shale & sand
2359	3060	Shale
3060	3360	Lime & shale
3360	3705	Shale & lime
3705	3859	Lime & shale
3859	3896	Shale & lime
3896	3910	Lime
3910	3960	Shale & lime
3960	4045	Lime
4045	4116	Shale & lime
4116	4195	Lime
4195	4315	Lime & shale
	4315	Rotary Total Depth

Spud hole at 7:45 p.m., July 11, 1978. Drilled 215' of 12 1/4" hole. Ran 5 joints of 8-5/8" - 28# steel casing. Set at 208.50' K.B. with 150 sacks of common cement, 2% gel, 3% CaCl. Plug was down at 12:30 a.m., July 12, 1978. Cement did circulate.

T.D. 4315'. Set first plug at 1150' with 70 sacks, second plug at 200' with 20 sacks, third plug at 40' - solid bridge - with 10 sacks. Sun Cement. Plug was down at 7:00 p.m., July 20, 1978. State Plugger - Gilbert Balthazor.

SAMPLE TOPS:

Anhydrite 2226'
B/Anhydrite 2258'

RECEIVED
STATE CORPORATION COMMISSION
JUL 25 1978
CONSERVATION DIVISION
Wichita, Kansas

STATE OF KANSAS)
) ss
COUNTY OF SEDGWICK)


Jerry A. Langrehr, Executive Vice President of Abercrombie Drilling, Inc., does hereby state that the above and foregoing is a true and correct copy of the log of the Jacobs #1, SW-NE-SW, Sec. 32-9S-25W, Graham County, Kansas.

ABERCROMBIE DRILLING, INC.

By Jerry A. Langrehr
Jerry A. Langrehr,
Executive Vice President

Subscribed and sworn to before me, a Notary Public, in and for the county and state aforesaid, as of this 24th day of July, 1978.

Sandra Richman
Sandra Richman, Notary Public

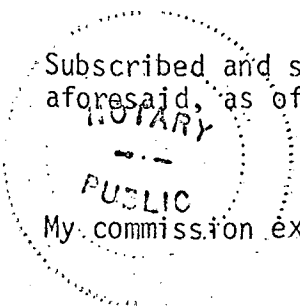

My commission expires July 21, 1979.