

WELL PLUGGING RECORD

FORMATION PLUGGING RECORD


Strike out upper line when reporting plugging off formations.

STATE OF KANSAS STATE CORPORATION COMMISSION

Give All Information Completely Make Required Affidavit Mail or Deliver Report to: Conservation Division State Corporation Commission 800 Bitting Building Wichita, Kansas

Graham County. Sec. 27 Twp. 9 Rge. (E) 25 (W) Location as "NE 1/4 NW 1/4 SW 1/4" or footage from lines. 330N 990E of SW Corner Lease Owner: Cities Service Oil Company Lease Name: Rome Office Address: Bartlesville, Oklahoma Character of Well (completed as Oil, Gas or Dry Hole): Dry Hole Date well completed: 9-10 Application for plugging filed: 9-10 Application for plugging approved: 9-11 Plugging commenced: 9-11 Plugging completed: 9-11 Reason for abandonment of well or producing formation: Dry Hole

NORTH

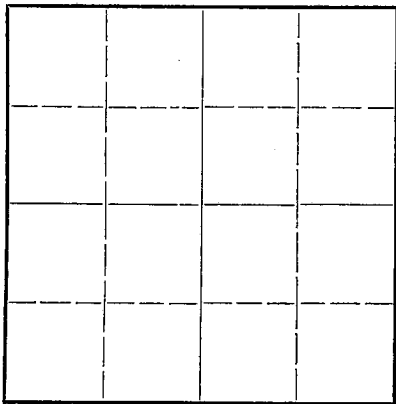

Locate well correctly on above Section Plat

If a producing well is abandoned, date of last production: 19... Was permission obtained from the Conservation Division or its agents before plugging was commenced? Yes

Name of Conservation Agent who supervised plugging of this well: Mr. Herb Kerr Producing formation: Arbuckle lime Depth to top: Bottom: Total Depth of Well: 4600 Feet Show depth and thickness of all water, oil and gas formations.

OIL, GAS OR WATER RECORDS


CASING RECORD

Table with 7 columns: Formation, Content, From, To, Size, Put In, Pulled Out. Rows include Topeka, Lansing, Conglomerate, Mississippi, Viola, and Arbuckle.

Describe in detail the manner in which the well was plugged, indicating where the mud fluid was placed and the method or methods used in introducing it into the hole. If cement or other plugs were used, state the character of same and depth placed, from... feet to... feet for each plug set.

Filled with heavy mud from total depth 4600' to 400' set plug dumped 15 sacks cement mud to 25' dumped 10 sacks cement, mud and dirt to surface.

PLUGGING FILE # 27-9-R-25W BOOK PAGE 71 LINE 21

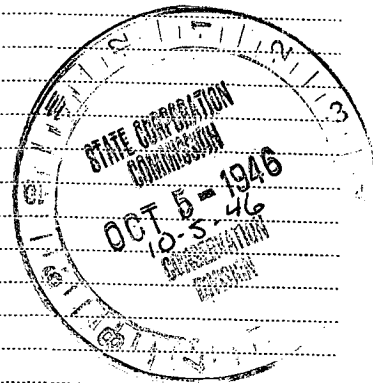

(If additional description is necessary, use BACK of this sheet)

Correspondence regarding this well should be addressed to: Mr. R. C. Hauber Address: Cities Service Oil Company Great Bend, Kansas

STATE OF Kansas, COUNTY OF Barton, Mr. James Porter (employee of owner) or (owner or operator) of the above-described well, being first duly sworn on oath, says: That I have knowledge of the facts, statements, and matters herein contained and the log of the above-described well as filed and that the same are true and correct. So help me God.

(Signature)

Box 553 Russell, Kansas (Address)

SUBSCRIBED AND SWORN to before me this 24th day of Sept 1946

commission expires 3-12-47

Notary Public.

Company Citico Service Oil Co. Well No. 1 Farm None
 Location 330' North and 990' East of SW Corner Sec. 27 T. 9 R. 25N
 Elevation 2546 (Or. 2543) County Orchen State Kansas
 Drig. Comm. August 12, 1946 Contractor Corbett-Harbor Drilling Company
 Drig. Comp. September 9, 1946 Acid None
 T. D. 1600' Initial Prod. Dry & Abandoned - P. & A. Sept. 10, 1946

CASING RECORD:

8-5/8" • 400' con. 100' air cement

FORMATION LOGGED:


sand	0-55
shale & shalle	130
sand	135
shale & shalle	220
shale	400
shale & sand	930
shale & shalle	1600
shale	1675
shale & shalle	1695
red bed & shale	1975
red bed	2100
lime	2200
conhydrite	2225
lime & shale	2300
lime	2325
shale	2400
shale & shalle	2543
shale	2635
shale & shalle	3000
broken lign	3115
shale & shalle	3190
lime	4044
shale	4105
lime	4123
shale	4168
lime	4195
shale	4316
sand conglomerate	4335
shale	4370
lime	4600 T. D.

Top Landing	3760'
Top Mississippi	4363'
Top Viola	4474'
Top Ardmore	4490'
Penetration	110'
Total Depth	4600'

Drill stem tool 3327-39, rec.
 230' salt water in 30 min.

8 1/2"	500'	00
	1000'	00
	1500'	00
	2000'	00
	2500'	10
	3000'	00
	3500'	00

9-7/8" rotary hole.

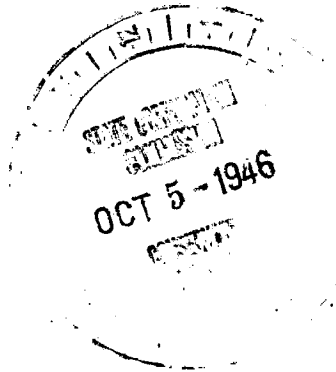

PLUGGING
 FILE REC 27-9-825W
 BOOK PAGE 71-LINE 21