


Give All Information Completely  
Make Required Affidavit  
Mail or Deliver Report to:  
Conservation Division  
State Corporation Commission  
212 No. Market  
Wichita, Kansas

WELL PLUGGING RECORD

NORTH

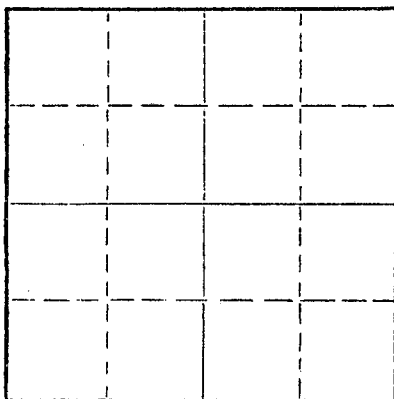

Locate well correctly on above  
Section Plat

Graham County, Sec. 27 Twp. 9 Rge. 25 (E) W (W)  
Location as "NE/CNW/SW" or footage from lines C NW NW  
Lease Owner Rosen Oil Company  
Lease Name Rome Well No. 1  
Office Address 605 Sutton Place, Wichita, Kansas 67202  
Character of Well (completed as Oil, Gas or Dry Hole) Dry Hole  
Date well completed 11-4 1968  
Application for plugging filed 11-4 1968  
Application for plugging approved 11-4 1968  
Plugging commenced 11-4 1968  
Plugging completed 11-4 1968  
Reason for abandonment of well or producing formation Dry Hole

If a producing well is abandoned, date of last production 19  
Was permission obtained from the Conservation Division or its agents before plugging was commenced? Yes

Name of Conservation Agent who supervised plugging of this well W. L. Nichols  
Producing formation \_\_\_\_\_ Depth to top \_\_\_\_\_ Bottom \_\_\_\_\_ Total Depth of Well \_\_\_\_\_ Feet  
Show depth and thickness of all water, oil and gas formations.

OIL, GAS OR WATER RECORDS

CASING RECORD

FORMATION	CONTENT	FROM	TO	SIZE	PUT IN	PULLED OUT
Surface Pipe				8 5/8"	255'	

Describe in detail the manner in which the well was plugged, indicating where the mud fluid was placed and the method or methods used in introducing it into the hole. If cement or other plugs were used, state the character of same and depth placed, from \_\_\_\_\_ feet to \_\_\_\_\_ feet for each plug set.

- 1st. plug was set @ 1300' with 70 sacks cement
- 2nd. plug was set @ 270' with 20 sacks cement
- 3rd. plug was set @ 40' with 10 sacks cement
- Cementing to bottom of cellar

RECEIVED  
STATE CORPORATION COMMISSION  
NOV 6 1968 11-6-68  
CONSERVATION DIVISION  
Wichita, Kansas


(If additional description is necessary, use BACK of this sheet)

Name of Plugging Contractor L. J. Dreiling & Sons, Inc.  
Address Route 2, Victoria, Kansas 67671

STATE OF KANSAS, COUNTY OF ELLIS, ss.  
I, Leo F. Dreiling (employee of owner) or ~~CONSERVATION DIVISION~~ of the above-described

well, being first duly sworn on oath, says: That I have knowledge of the facts, statements, and matters herein contained and the log of the above-described well as filed and that the same are true and correct. So help me God.

(Signature) Leo F. Dreiling  
LEO F. DREILING, ROUTE 2, VICTORIA, KANSAS 67671  
(Address)

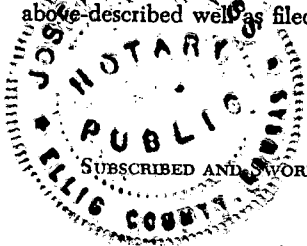

SUBSCRIBED AND SWORN to before me this 5th day of November, 19 68

My commission expires September 19, 1970 JOSEPH A. HESS Notary Public.

# L. J. DREILING AND SONS, INC.

Victoria, Kansas 67671

## WELL LOG

<b>Company</b>	Rosen Oil Company 605 Sutton Place Wichita, Kansas 67202	<b>Sec. 27</b>	<b>Twp. 9</b>	<b>Rng. 25</b>
<b>Farm</b>	Rome No. 1	<b>Location</b>	C NW NW	
<b>Total Depth</b>	4100'	<b>County</b>	Graham	
<b>Comm.</b>	10-28-68	<b>Comp.</b>	11-4-68	<b>Elevation:</b> 2579' K. B.
<b>Contractor</b>	L. J. Dreiling & Sons, Inc. Victoria, Kansas 67671			2576' D. F.
	<b>Casing Record</b>	<b>Cement Record</b>		2574' G. R.
	255' - 8 5/8"	150 sacks cement		<b>Production:</b> D & A

### Figures Indicate Bottom of Formations

0'	40'	Surface Soil
40'	70'	Clay
70'	180'	Sand
180'	255'	Blue Shale
255'	837'	Shale & Shells
837'	1795'	Shale & Sand Streaks
1795'	1980'	Sand
1980'	2210'	Shale & Redbed
2210'	2249'	Anhy.
2249'	2695'	Shale & Shells
2695'	3315'	Lime & Shale
3315'	3470'	Lime
3470'	3600'	Lime & Shale
3600'	4100'	Lime
4100'	T.D.	

RECEIVED  
 STATE CORPORATION COMMISSION  
 NOV 6 1968  
 CONSERVATION DIVISION  
 WICHITA, KANSAS

STATE OF KANSAS)  
 )ss  
 COUNTY OF ELLIS)

I, Leo F. Dreiling, of the L. J. Dreiling & Sons, Inc., upon oath states that the above and foregoing is a true and correct copy from the Daily Drilling Report from your Rome #1.

*Leo F. Dreiling*  
 \_\_\_\_\_  
 LEO F. DREILING

Subscribed and sworn to before me this 5th day of November 1968.

*Joseph A. Hess*  
 \_\_\_\_\_  
 JOSEPH A. HESS NOTARY PUBLIC

My commission expires: September 19, 1970

