


Give All Information Completely  
Make Required Affidavit  
Mail or Deliver Report to:  
Conservation Division  
State Corporation Commission  
211 No. Broadway  
Wichita, Kansas

WELL PLUGGING RECORD

NORTH

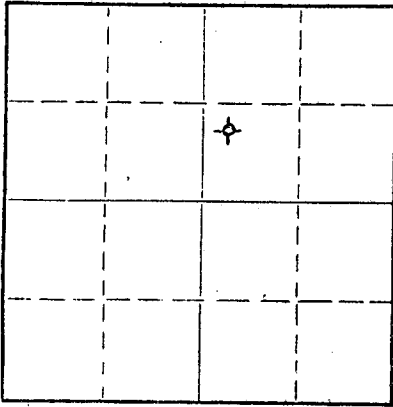

Locate well correctly on above  
Section Plat

Ellis County, Sec. 4 Twp. 11S Rge. 18 (E) W (W)  
Location as "NE/CNW/SW" or footage from lines NW SW NE

Lease Owner Hall-Jones  
Lease Name Warner  
Office Address 1704 Liberty Bank Bldg., Oklahoma City, Okla.  
Character of Well (completed as Oil, Gas or Dry Hole) Dry Hole  
Date well completed December 17, 1965  
Application for plugging filed December 17, 1965  
Application for plugging approved December 17, 1965  
Plugging commenced December 17, 1965  
Plugging completed December 17, 1965  
Reason for abandonment of well or producing formation Too low structurally

If a producing well is abandoned, date of last production 19  
Was permission obtained from the Conservation Division or its agents before plugging was commenced? Yes

Name of Conservation Agent who supervised plugging of this well Gilbert Leiker  
Producing formation \_\_\_\_\_ Depth to top \_\_\_\_\_ Bottom \_\_\_\_\_ Total Depth of Well 3570 Feet  
Show depth and thickness of all water, oil and gas formations.

OIL, GAS OR WATER RECORDS

CASING RECORD

FORMATION	CONTENT	FROM	TO	SIZE	PUT IN	PULLED OUT
				8-5/8"	249	

Describe in detail the manner in which the well was plugged, indicating where the mud fluid was placed and the method or methods used in introducing it into the hole. If cement or other plugs were used, state the character of same and depth placed, from \_\_\_\_\_ feet to \_\_\_\_\_ feet for each plug set.

Filled with heavy mud to 540'. Set plug. Put in 20 sx cement. Filled with heavy mud to 240'. Set plug. Put in 25 sx cement. Filled with heavy mud up to 40'. Set plug. Filled to top with 1-1/2 sx hulls and 10 sx cement.

RECEIVED  
STATE CORPORATION COMMISSION

12-28-1965  
DEC 28 1965


CONSERVATION DIVISION  
Wichita, Kansas

Name of Plugging Contractor C-G Drilling Co.  
Address 107 Rule Bldg., Wichita 2, Kansas

STATE OF Kansas, COUNTY OF Sedgwick, ss.  
G. F. Galloway (employee of owner) or ~~owner~~ of the above-described well, being first duly sworn on oath, says: That I have knowledge of the facts, statements, and matters herein contained and the log of the above-described well as filed and that the same are true and correct. So help me God.

(Signature) G. F. Galloway  
G. F. Galloway  
107 Rule Building  
(Address)

Subscribed and sworn to before me this 20th day of December 19 65  
My commission expires May 20, 1967

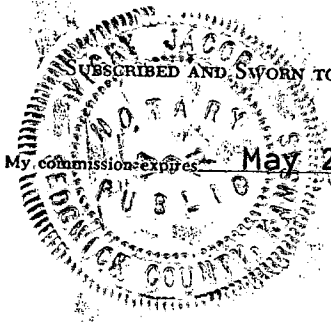

Vicky Jacobs  
Notary Public.

**RECEIVED**  
STATE CORPORATION COMMISSION

12-28-1965  
DEC 28 1965

CONSERVATION DIVISION  
Wichita, Kansas

W E L L      L O G

OPERATOR: Hall-Jones  
 WELL NAME: Warner #1      LOCATION: NW SW NE 4-11S-18W  
 COUNTY: Ellis      STATE: Kansas  
 WELL COMMENCED: Dec. 8, 1965      WELL COMPLETED: Dec. 17, 1965  
 ELEVATION: 1977 KB      TOTAL DEPTH: 3570'  
 PRODUCTION: Dry & Abandoned      RIG NO: #1  
 CASING - 8-5/8": 8 jts., 249' w/170 sx Pozmix cement  
                   5-1/2": \_\_\_\_\_

All Measurements taken from the top of rotary bushing.

FROM	TO	FORMATION	DEVIATION FROM VERTICAL	REMARKS:
0	249	Sand & Shale		
249	800	Shale	1/2	700'
800	995	Sand		
995	1330	Red Bed & Shale	2.	1200'
1330	1360	Anhydrite		
1360	1440	Shale	1-1/2	1410'
1440	1855	Shale & Shells	1-1/4	1510'
1855	3245	Lime & Shale	1-1/4	1850'      DST #1 3184-3245'
3245	3553	Lime	3/4	2500'
3553	3570	Chert-Conglomerate	1/2	3000'

STATE OF KANSAS      )  
 COUNTY OF SEDGWICK) SS:

The undersigned hereby certifies that to the best of his knowledge and belief, the above facts are true and correct.

C-G DRILLING CO.

By *J. Gallaway*

SUBSCRIBED AND SWORN TO, BEFORE ME, This 18th day of December, 1965.  
 My comm. exp. May 20, 1967

*Vicky Jacobs*  
 Vicky Jacobs - Notary Public

