


WELL PLUGGING RECORD

Give All Information Completely
Make Required Affidavit
Mail or Deliver Report to:
Conservation Division
State Corporation Commission
211 No. Broadway
Wichita, Kansas

NORTH

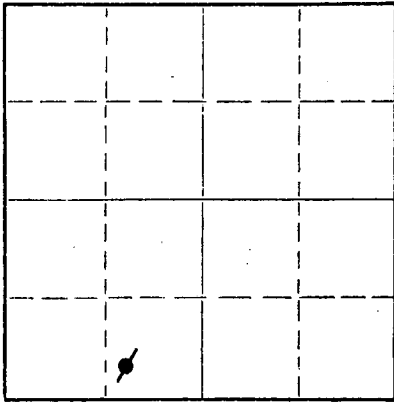

Locate well correctly on above
Section Plat

Ellis County, Sec. 28 Twp. 11 Rge. 18 (E) W (W)
Location as "NE/CNW/SW" or footage from lines. SW SE SW
Lease Owner C-G DRILLING CO.
Lease Name FISHER Well No. 2
Office Address 107 Rule Bldg., Wichita, Kansas
Character of Well (completed as Oil, Gas or Dry Hole) Oil
Date well completed April 25 1955
Application for plugging filed April 16 1956
Application for plugging approved April 16 1956
Plugging commenced April 17 1956
Plugging completed April 17 1956
Reason for abandonment of well or producing formation No longer commercial

If a producing well is abandoned, date of last production September 28 1955
Was permission obtained from the Conservation Division or its agents before plugging was commenced? Yes

Name of Conservation Agent who supervised plugging of this well Eldon Petty, Hays, Kansas
Producing formation Arbuckle Depth to top 3627 Bottom 3635 Total Depth of Well 3635 Feet
Show depth and thickness of all water, oil and gas formations.

OIL, GAS OR WATER RECORDS

CASING RECORD

FORMATION	CONTENT	FROM	TO	SIZE	PUT IN	PULLED OUT
				8-5/8"	181'	none
				5-1/2"	3650'	none

Describe in detail the manner in which the well was plugged, indicating where the mud fluid was placed and the method or methods used in introducing it into the hole. If cement or other plugs were used, state the character of same and depth placed, from _____ feet to _____ feet for each plug set.

Put in 30 sacks Gel. Set Plug.
Put in 40 sacks cement to top
of hole. Done by Globe Cement Co.

(If additional description is necessary, use BACK of this sheet)

Name of Plugging Contractor C-G Drilling Co.
Address 107 Rule Building, Wichita, Kansas

STATE OF KANSAS, COUNTY OF SEDGWICK, ss.
G. F. Galloway (employee of owner) or (owner or operator) of the above-described well, being first duly sworn on oath, says: That I have knowledge of the facts, statements, and matters herein contained and the log of the above-described well as filed and that the same are true and correct. So help me God.

(Signature) *G. F. Galloway*
G. F. Galloway
107 Rule Bldg.
(Address)



Ricky Jacobs
STATE CORPORATION COMMISSION
5-1-1956
MAY 1 1956
Notary Public.

PLUGGING
FILE SEC 28 T 11 R 18W
BOOK PAGE 55 LINE 6

CONSERVATION DIVISION
Wichita, Kansas

15-051-30644-00-00

CONTRACTOR'S WELL LOG

OPERATOR C-G DRILLING CO. WELL NAME FISHER #1

LOCATION SW SE SW Sec. 28-11S-18W RIG NO. 1

COUNTY ELLIS STATE KANSAS

COMMENCEMENT DATE APRIL 10, 1955 COMPLETION DATE APRIL 19, 1955

LOG OF WELL

Elevation 2093' Rotary bushing.
All measurements taken from top of rotary bushing.

FROM	TO	FORMATION	DEVIATION FROM VERTICAL	REMARKS
0	181	Surface Soil		
181	200	Shale		
200	670	Shale-Sand		
670	760	Sand		
760	900	Shale		
900	1100	Sand		
1100	1300	Red Bed		
1300	1376	Red Bed		
1376	1415	Anhydrite		
1415	1735	Shale-Shells		
1735	2075	Shale-Shells		
2075	2265	Lime-Shale		
2265	2385	Lime-Shale		
2385	2460	Lime-Shale		
2460	2630	Lime-Shale	0° - 2500	
2630	2775	Lime-Shale	0° - 2750	
2775	2875	Lime-Shale		
2875	3015	Lime-Shale	0° - 3000	
3015	3145	Lime-Shale		
3145	3215	Lime-Shale		
3215	3290	Lime-Shale	0° - 3250	
3290	3338	Lime-Shale		
3338	3435	Lime-Shale		
3435	3535	Lime-Shale	0° - 3500	DST 3516 - 52
3535	3635	Lime-Shale		

CASING LEFT IN HOLE AFTER COMPLETION

181' of 8-5/8" OD Surface Casing
3650' (115 jts.) 5-1/2" Casing

COUNTY OF SEDGWICK, STATE OF KANSAS) ss.

The undersigned hereby certifies that to the best of his knowledge and belief, the above facts are true and correct.

C-G DRILLING CO.

By G. F. Galloway
G. F. Galloway

Subscribed and sworn to before me this 24th day of April, 1956.

My commission expires:
May 20, 1959

Vicky Jacobs
Vicky Jacobs, Notary Public

PLUGGING
FILE SEC 28 T 11 R 18 W
BOOK PAGE 55 LINE 6
MAILED
5-1-1956
CONSERVATION DIVISION
Wichita, Kansas