


Give All Information Completely  
Make Required Affidavit  
Mail or Deliver Report to:  
Conservation Division  
State Corporation Commission  
800 Biting Building  
Wichita, Kansas

ELLIS County. Sec. 28 Twp. 11 Rge. 18 (E) W (W)  
Location as "NE/CNW/SW" or footage from lines NE NE SW  
Lease Owner C-G DRILLING CO.  
Lease Name FISHER Well No. 1  
Office Address 107 Rule Building, Wichita, Kansas  
Character of Well (completed as Oil, Gas or Dry Hole) Dry Hole  
Date well completed 4-8 1954  
Application for plugging filed 4-8 1954  
Application for plugging approved 4-8 1954  
Plugging commenced 4-8 1954  
Plugging completed 4-8 1954  
Reason for abandonment of well or producing formation Too low structurally

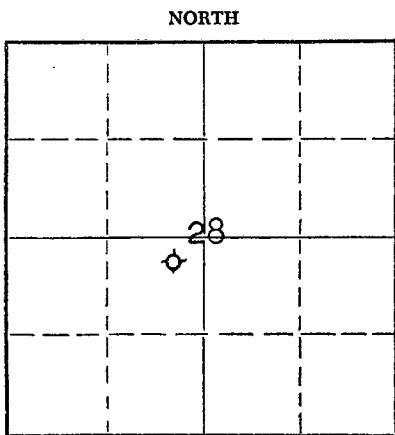

Locate well correctly on above Section Plat

If a producing well is abandoned, date of last production -- 19  
Was permission obtained from the Conservation Division or its agents before plugging was commenced? Yes

Name of Conservation Agent who supervised plugging of this well Eldon Petty, Hays, Kansas  
Producing formation -- Depth to top -- Bottom -- Total Depth of Well 3675 Feet  
Show depth and thickness of all water, oil and gas formations.

OIL, GAS OR WATER RECORDS

CASING RECORD

FORMATION	CONTENT	FROM	TO	SIZE	PUT IN	PULLED OUT
				8-5/8	177.88	

Describe in detail the manner in which the well was plugged, indicating where the mud fluid was placed and the method or methods used in introducing it into the hole. If cement or other plugs were used, state the character of same and depth placed, from -- feet to -- feet for each plug set.

Filled hole with mud to 175'; set plug; 1/2 sack hulls, 15 sacks cement. Filled hole with mud to 40'; set plug then filled to top with 10 sacks cement, 1/2 sack hulls.

(If additional description is necessary, use BACK of this sheet)  
Name of Plugging Contractor C-G DRILLING CO.  
Address 107 Rule Building, 321 E. Williams, Wichita, Kansas

STATE OF KANSAS, COUNTY OF SEDGWICK, ss.  
Vicky Jacobs (employee of owner) or (XXXXXX) of the above-described well, being first duly sworn on oath, says: That I have knowledge of the facts, statements, and matters herein contained and the log of the above-described well as filed and that the same are true and correct. So help me God.

(Signature) Vicky Jacobs  
Office Manager  
107 Rule Building, Wichita, Kansas  
(Address)

SUBSCRIBED AND SWORN TO before me this 14th day of April, 1954

My commission expires June 17, 1957

Barbara Donaldson  
Notary Public.

24-7368-S 3-53-20M

PLUGGING  
FILE SEC 28 T 11 R 18W  
BOOK PAGE 25 LINE 37

RECEIVED  
STATE CORPORATION COMMISSION  
4-15-1954  
APR 15 1954  
CONSERVATION DIVISION  
Wichita, Kansas

15-051-03513-00-00

CONTRACTOR'S WELL LOG

OPERATOR C-G Drilling Co. FARM NAME Fisher #1  
LOCATION NE NE SW, Sec. 28-11-18w  
POOL NAME Burnett Southwest COUNTY Ellis STATE Kansas  
COMMENCEMENT DATE 3-31-54 COMPLETION DATE 4-8-54

LOG OF WELL

Elevation: 2075 R.B.  
All measurements from the top of rotary bushing.

FROM	TO	FORMATION	DEVIATION FROM VERTICAL	REMARKS:
0	178	Shale		
178	860	Shale		
860	1025	Sand		
1025	1364	Red Bed		
1364	1402	Anhydrite		
1402	1700	Shale	0° - 1500'	
1700	2090	Shale-Shells	0° - 2000'	
2090	2300	Lime-Shale		
2300	2475	Lime-Shale		
2425	2615	Lime-Shale	0° - 2500'	
2615	2770	Lime-Shale		
2770	2915	Lime-Shale		
2915	3000	Lime-Shale	0° - 3000'	
3000	3125	Lime-Shale		
3125	3210	Lime-Shale		
3210	3269	Lime-Shale		
3269	3330	Lime-Shale		
3330	3385	Lime-Shale		
3385	3422	Lime-Shale		
3422	3485	Lime-Shale		
3485	3545	Lime-Shale	0° - 3500'	
3545	3610	Lime-Shale		
3610	3665	Lime-Shale		
3556	3675	Lime-Shale		

CASING LEFT IN HOLE AFTER COMPLETION

Ran 177.88' (6 jts) 8-5/8" Surface Casing.

STATE OF KANSAS, COUNTY OF SEDGWICK ) ss.

The undersigned certifies that to the best of her knowledge and belief, the above facts are true and correct.

C-G DRILLING CO.

By Wicky Jacobs  
Office Manger

Subscribed and sworn to before me this 14th day of April, 1954.

My commission expires: June 17, 1957

Barbara Donaldson  
Notary Public

RECEIVED  
STATE CORPORATION COMM. DIV.  
4-15-1954  
APR 15 1954

CONSERVATION DIVISION  
Wichita, Kansas

PLUGGING  
WELL SEC 28 T 11 R 18W  
BOOK PAGE 23 LINE 37

