

15-065-01612-0000


STATE OF KANSAS  
STATE CORPORATION COMMISSION

Form CP-4

Give All Information Completely  
Make Required Affidavit  
Mail or Deliver Report to:  
Conservation Division  
State Corporation Commission  
212 No. Market  
Wichita, Kansas

WELL PLUGGING RECORD

NORTH

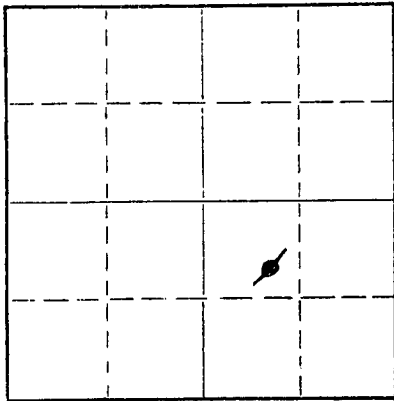

Locate well correctly on above  
Section Plat

Graham County. Sec. 10 Twp. 9s Rge. (R24W-W)  
Location as "NE/CNW/SW" or footage from lines SE 1/4 NW 1/4 SE 1/4  
Lease Owner Birmingham-Bartlett Drilling Co.  
Lease Name Nickelson Well No. 2  
Office Address 300 Kaufman Building, Wichita, Kansas 67202  
Character of Well (completed as Oil, Gas or Dry Hole) oil  
Date well completed September 27 19 57  
Application for plugging filed June 5 19 67  
Application for plugging approved June 6 19 67  
Plugging commenced June 16 19 67  
Plugging completed June 20 19 67  
Reason for abandonment of well or producing formation production declined to a point where well no longer economical to operate.  
If a producing well is abandoned, date of last production February 1, 19 67  
Was permission obtained from the Conservation Division or its agents before plugging was commenced? yes

Name of Conservation Agent who supervised plugging of this well W. L. Nichols, Box 157, Morland, Kansas  
Producing formation lansing Depth to top 3840 Bottom            Total Depth of Well 4060 Feet  
Show depth and thickness of all water, oil and gas formations.

OIL, GAS OR WATER RECORDS

CASING RECORD

FORMATION	CONTENT	FROM	TO	SIZE	PUT IN	PULLED OUT
		0'	180'	8-5/8"	180'	none
		0'	4059'	5-1/2"	4059'	1479.95'

Describe in detail the manner in which the well was plugged, indicating where the mud fluid was placed and the method or methods used in introducing it into the hole. If cement or other plugs were used, state the character of same and depth placed, from            feet to            feet for each plug set.

<u>4060' - 4010'</u>	<u>plug</u>
<u>4010' - 3975'</u>	<u>sand</u>
<u>3975' - 3935'</u>	<u>5 sacks cement</u>
<u>3935' - 225'</u>	<u>pumped 35 sacks gel mud and 4 sacks of hulls</u>
<u>225' - base</u>	<u>pumped 75 sacks cement</u>

RECEIVED  
STATE CORPORATION COMMISSION  
7-10-67 JUL 10 1967  
CONSERVATION DIVISION  
WICHITA, KANSAS

(If additional description is necessary, use BACK of this sheet)

Name of Plugging Contractor Santa Fe Pipe & Supply, Inc.,  
Address P. O., Box 562, Great Bend, Kansas


STATE OF Kansas, COUNTY OF Barton, ss.  
Ted L. Nutt (employee of owner) or (owner or operator) of the above-described well, being first duly sworn on oath, says: That I have knowledge of the facts, statements, and matters herein contained and the log of the above-described well as filed and that the same are true and correct. So help me God.

(Signature) Ted L. Nutt  
Box 562, Great Bend, Kansas  
(Address)

SUBSCRIBED AND SWORN TO before me this 30 day of June, 19 67

Mary M. Guesnier  
Notary Public.

My commission expires July 31, 1970

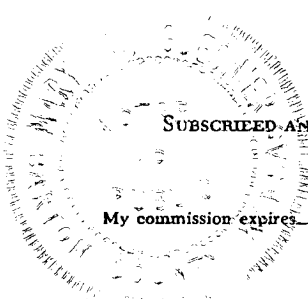

DRILLING LOG

Company: Birmingham-Bartlett  
 Lease: #2 Nickolson  
 Location: SE NW SE 10-99-24W  
 Graham County, Kansas  
 Contractor: Woodman & Iannitti Drilling Co.  
 Date Commenced: 9-16-57  
 Date Completed: 9-25-57  
 Total Depth: 4060'  
 Casing: 8 5/8" at 181' with 100 sacks cement  
 5 1/2" at 4059' with 100 sacks cement

Figures Indicate the Bottom of Formation

0-165	Sand	3545	Lime
180	Blue Shale	3675	Shale - Lime
650	Shale	3725	Lime
1162	Shale	3780	Lime
1560	Sand & Shale	3832	Lime
1910	Sand & Shale	3873	Lime
2162	Red Bed & Shale	3882	Lime
2195	Anhydrite	3923	Lime
2200	Anhydrite	3962	Lime
2495	Red Bed Shale & Shells	4013	Lime
2705	Shale & Lime	4023	Lime
2950	Shale & Lime	4060	Lime
3000	Lime		
3245	Shale & Lime		
3365	Lime & Shale		
3450	Lime		

RECEIVED  
 STATE CORPORATION COMMISSION  
 SEP 26 1957  
 INVESTIGATION DIVISION  
 TOPEKA, KANSAS

I certify the above to be a true and correct copy of the Driller's Log to the best of my knowledge and belief.

WOODMAN & IANNITTI DRILLING CO.

By K. T. Woodman  
 K. T. Woodman