


TEXACO INC.—LOG OF WELL

DIVISION

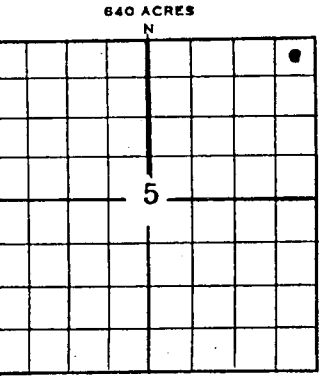

WELL Keith B-C #1 L. D. FILE NO. _____

LOC. NE NE NE SEC. 5 TWP. 9S RGE. 24W

DIST. _____ CO.-PARISH Graham STATE Kansas

COMM. DRLG. 10/13/55 COMP. DRLG. 10/24/55 DAYS DRLG. 11

ROT. FROM 0 TO 4025 CABLE FROM _____ TO _____

CONTR. OR CO. RIG NO. Ferrell Drlg. Co. T. D. DRILLED 4025

OMP. T. D. 4025 ZERO ELEV. 2468 KB GRD. ELEV. _____ CSG. FLG. ELEV. _____

DATE OF FIRST PROD. 11/1/55 OFFICIAL COMP. DATE 11/1/55

LOGS RUN Welex Radioactivity Log

CASING RECORD

SIZE INCHES	DEPTH FEET	WEIGHT #/FT.	GRADE	RANGE	REMARKS—QUAN. CMT., TEMP. SURV., ETC.
8-5/8	240				200 Sacks cmt.
5-1/2	4025				150 Sacks cmt.

COMPLETION DATA

FORMATION	Lansing				
DATE OF TEST	11/1/55				
DEPTH OF PROD. INTERVAL	3954-3958				
INITIAL PRODUCTION:	OIL - BPD	360			
	GAS - MCF				
	WATER - BPD				
	GOR				
	BHP - PSI				
CORRECTED API GRAVITY					
PRODUCING CONDITIONS	casing swab				
ARTIFICIAL STIMULATION	2000 gal. acid				

REMARKS

WELL _____ FIELD _____ AREA _____