


KANSAS CORPORATION COMMISSION  
WELL RECORD

RECEIVED  
STATE CORPORATION COMMISSION  
JAN 28 1972  
CONSERVATION DIVISION  
Wichita, Kansas

(Mail to Kansas Geological Survey, 4150 Monroe Street, Wichita, Kansas 67209)

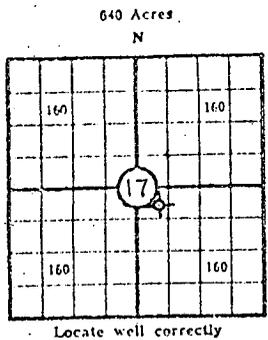

Lease Name: Martin Well No. 1  
Well Located: 440' FWL and 440' FNL SE/4  
SEC 17 TWP 9S RGE 25W  
Operator: Empire Drilling Co.  
Address: 650 Fourth National Bank Bldg.  
Elevation: Ground 2620 D.F. 2622 K.B. 2625  
Type Well: (Oil, gas, dry hole)

Drilling Commenced: 1/5 1972 Drilling Completed: 1/12 1972  
Well Completed: 1/12 1972 Total Depth 4140'  
Initial Production: \_\_\_\_\_

Casing Record

Size: 8 5/8" Set at 239' Size: \_\_\_\_\_ Set at \_\_\_\_\_  
Size: \_\_\_\_\_ Set at \_\_\_\_\_ Size: \_\_\_\_\_ Set at \_\_\_\_\_

Liner Record

Size: \_\_\_\_\_ Set from \_\_\_\_\_ To \_\_\_\_\_

Cementing

Casing Size	Sacks	Type Cement and Additives
<u>8 5/8"</u>	<u>150 sx</u>	<u>60/40 Poz. HOWCO</u>
_____	_____	_____
_____	_____	_____

Perforations

Formation	Perforated Interval and Number Shots
_____	_____
_____	_____
_____	_____

Electric Log Run (Show type log and depths covered)

None

(Fill in formation and related information on reverse side)

FORMATION, TESTING AND COMPLETION RECORD

Show Drill Stem Tests,  
Well Stimulation and  
Production Tests

Formation	Top	Bottom	
ANHYDRITE	2297	2340	<u>DST #1 3823-35</u> , 30-30-60-45, rec 1550' SW, FP 42-717#, ISIP 1265#, FSIP 1244#, strong blow throughout test
HOWARD	3659	3678	
TOPEKA	3678	3820	<u>DST #2 3877-3905</u> , weak blow for 24 minutes, flushed tool, no help, 30-30-30-30, rec 20' Mud, FP 42-63#, ISIP 527#, FSIP 622#.
OREAD	3820	3872	
HEEBNER	3872	3875	<u>DST #3 4072-4084</u> , 30-30-60-60, weak blow for 85 minutes, rec 45' Mud w/NS, ISIP 42#, FSIP 42#
TORONTO	3896	3904	
LANSING	3911		<u>DST #4 4084-4104</u> , weak blow 7 min, 30-30-60-60, rec 55' oil spotted Mud, ISIP 69#, FSIP 63#, IFP 42#, FFP 44#.
B/KANSAS CITY	4137		

RECEIVED  
STATE CORPORATION COMMISSION  
JAN 28 1972  
CONSERVATION DIVISION  
Wichita, Kansas