

KANSAS CORPORATION COMMISSION
OIL & GAS CONSERVATION DIVISION

WELL COMPLETION FORM
WELL HISTORY - DESCRIPTION OF WELL & LEASE

ORIGINAL

Form ACO-1
September 1999
Form Must Be Typed

Operator: License # 33887
Name: Coffeyville Resources Nitrogen Fertilizers, LLC
Address: P. O. Box 5000
City/State/Zip: Coffeyville, KS 67337
Purchaser: NA
Operator Contact Person: Douglas E. Robker
Phone: (620) 252-4452
Contractor: Name: Bill's Water Drilling
License: 33860
Wellsite Geologist: NA
Designate Type of Completion:
☐ New Well ☐ Re-Entry ☐ Workover
☐ Oil ☐ SWD ☐ SLOW ☐ Temp. Abd.
☐ Gas ☐ ENHR ☐ SIGW
☒ Dry ☒ Other (Core, WSW, Expl., Cathodic etc)
If Workover/Re-entry: Old Well Info as follows:
Operator: _____
Well Name: _____
Original Comp. Date: _____ Original Total Depth: _____
☐ Deepening ☐ Re-perf. ☐ Conv. to Enhr./SWD
☐ Plug Back ☐ Plug Back Total Depth
☐ Commingled ☐ Docket No. _____
☐ Dual Completion ☐ Docket No. _____
☐ Other (SWD or Enhr.?) ☐ Docket No. _____

<u>6/21/07</u>	<u>6/22/07</u>	<u>8/7/07</u>
Spud Date or Recompletion Date	Date Reached TD	Completion Date or Recompletion Date

API No. 15 - NA 125-31297-0600
County: Montgomery
NW SE NE Sec. 36 Twp. 34 S. R. 16 ☒ East ☐ West
1470 feet from S / (N) (circle one) Line of Section
1205 feet from (E) W (circle one) Line of Section
Footages Calculated from Nearest Outside Section Corner:
(circle one) NE SE NW SW
Lease Name: Coffeyville Resources Well #: CP-2
Field Name: NA
Producing Formation: NA
Elevation: Ground: 720 Kelly Bushing: NA
Total Depth: 250 ft Plug Back Total Depth: NA
Amount of Surface Pipe Set and Cemented at NA Feet
Multiple Stage Cementing Collar Used? ☐ Yes ☒ No
If yes, show depth set _____ Feet
If Alternate II completion, cement circulated from _____
feet depth to _____ w/ _____ sx cmt.

Drilling Fluid Management Plan
(Data must be collected from the Reserve Pit)
Chloride content NA ppm Fluid volume _____ bbls
Dewatering method used Collected in portable tank; slow drain thru screen.
Location of fluid disposal if hauled offsite: _____
Operator Name: NA
Lease Name: NA License No.: _____
Quarter _____ Sec. _____ Twp. _____ S. R. _____ ☐ East ☐ West
County: _____ Docket No.: _____

INSTRUCTIONS: An original and two copies of this form shall be filed with the Kansas Corporation Commission, 130 S. Market - Room 2078, Wichita, Kansas 67202, within 120 days of the spud date, recompletion, workover or conversion of a well. Rule 82-3-130, 82-3-106 and 82-3-107 apply. Information of side two of this form will be held confidential for a period of 12 months if requested in writing and submitted with the form (see rule 82-3-107 for confidentiality in excess of 12 months). One copy of all wireline logs and geologist well report shall be attached with this form. ALL CEMENTING TICKETS MUST BE ATTACHED. Submit CP-4 form with all plugged wells. Submit CP-111 form with all temporarily abandoned wells.

All requirements of the statutes, rules and regulations promulgated to regulate the oil and gas industry have been fully complied with and the statements herein are complete and correct to the best of my knowledge.

Signature: Douglas E. Robker
Title: Environmental Engineer Date: August 8, 2008
Subscribed and sworn to before me this 8th day of August,
2008
Notary Public: Paula Rae Benson
Date Commission Expires: 08/04/2010

PAULA RAE BENSON
Notary Public - State of Kansas
My Appt. Expires 08/04/2010

KCC Office Use ONLY

☐ Letter of Confidentiality Received
If Denied, Yes ☐ Date: _____
☐ Wireline Log Received
☐ Geologist Report Received
☐ UIC Distribution

Operator Name: Coffeyville Resources Nitrogen Fertilizers, LLC Lease Name: Coffeyville Resources Well #: CP-2
 Sec. 36 Twp. 34 S. R. 16 ☒ East ☐ West County: Montgomery

INSTRUCTIONS: Show important tops and base of formations penetrated. Detail all cores. Report all final copies of drill stems tests giving interval tested, time tool open and closed, flowing and shut-in pressures, whether shut-in pressure reached static level, hydrostatic pressures, bottom hole temperature, fluid recovery, and flow rates if gas to surface test, along with final chart(s). Attach extra sheet if more space is needed. Attach copy of all Electric Wireline Logs surveyed. Attach final geological well site report.

Drill Stem Tests Taken ☐ Yes ☒ No
 (Attach Additional Sheets)

Samples Sent to Geological Survey ☐ Yes ☒ No

Cores Taken ☐ Yes ☒ No

Electric Log Run ☐ Yes ☒ No
 (Submit Copy)

List All E. Logs Run:

☐ Log Formation (Top), Depth and Datum ☐ Sample
 Name Top Datum

CASING RECORD ☒ New ☐ Used							
Report all strings set-conductor, surface, intermediate, production, etc.							
Purpose of String	Size Hole Drilled	Size Casing Set (In O.D.)	Weight Lbs. / Ft.	Setting Depth	Type of Cement	# Sacks Used	Type and Percent Additives
Plastic Conductor Pipe	14"	8"	NA	25'	NA	NA	100% Bentonite Grout


ADDITIONAL CEMENTING / SQUEEZE RECORD				
Purpose: ☐ Perforate ☐ Protect Casing ☐ Plug Back TD ☐ Plug Off Zone	Depth Top Bottom	Type of Cement	#Sacks Used	Type and Percent Additives

Shots Per Foot	PERFORATION RECORD - Bridge Plugs Set/Type Specify Footage of Each Interval Perforated	Acid, Fracture, Shot, Cement Squeeze Record (Amount and Kind of Material Used)	Depth

TUBING RECORD		Size	Set At	Packer At	Liner Run ☐ Yes ☐ No
Date of First, Resumed Production, SWD or Enhr.		Producing Method ☐ Flowing ☐ Pumping ☐ Gas Lift ☐ Other (Explain)			
Estimated Production Per 24 Hours	Oil Bbls.	Gas Mcf	Water Bbls.	Gas-Oil Ratio	Gravity

Disposition of Gas	METHOD OF COMPLETION	Production Interval
☐ Vented ☐ Sold ☐ Used on Lease (If vented, Submit ACO-18.)	☐ Open Hole ☐ Perf. ☐ Dually Comp. ☐ Commingled ☐ Other (Specify)	

SESCO Deepwell

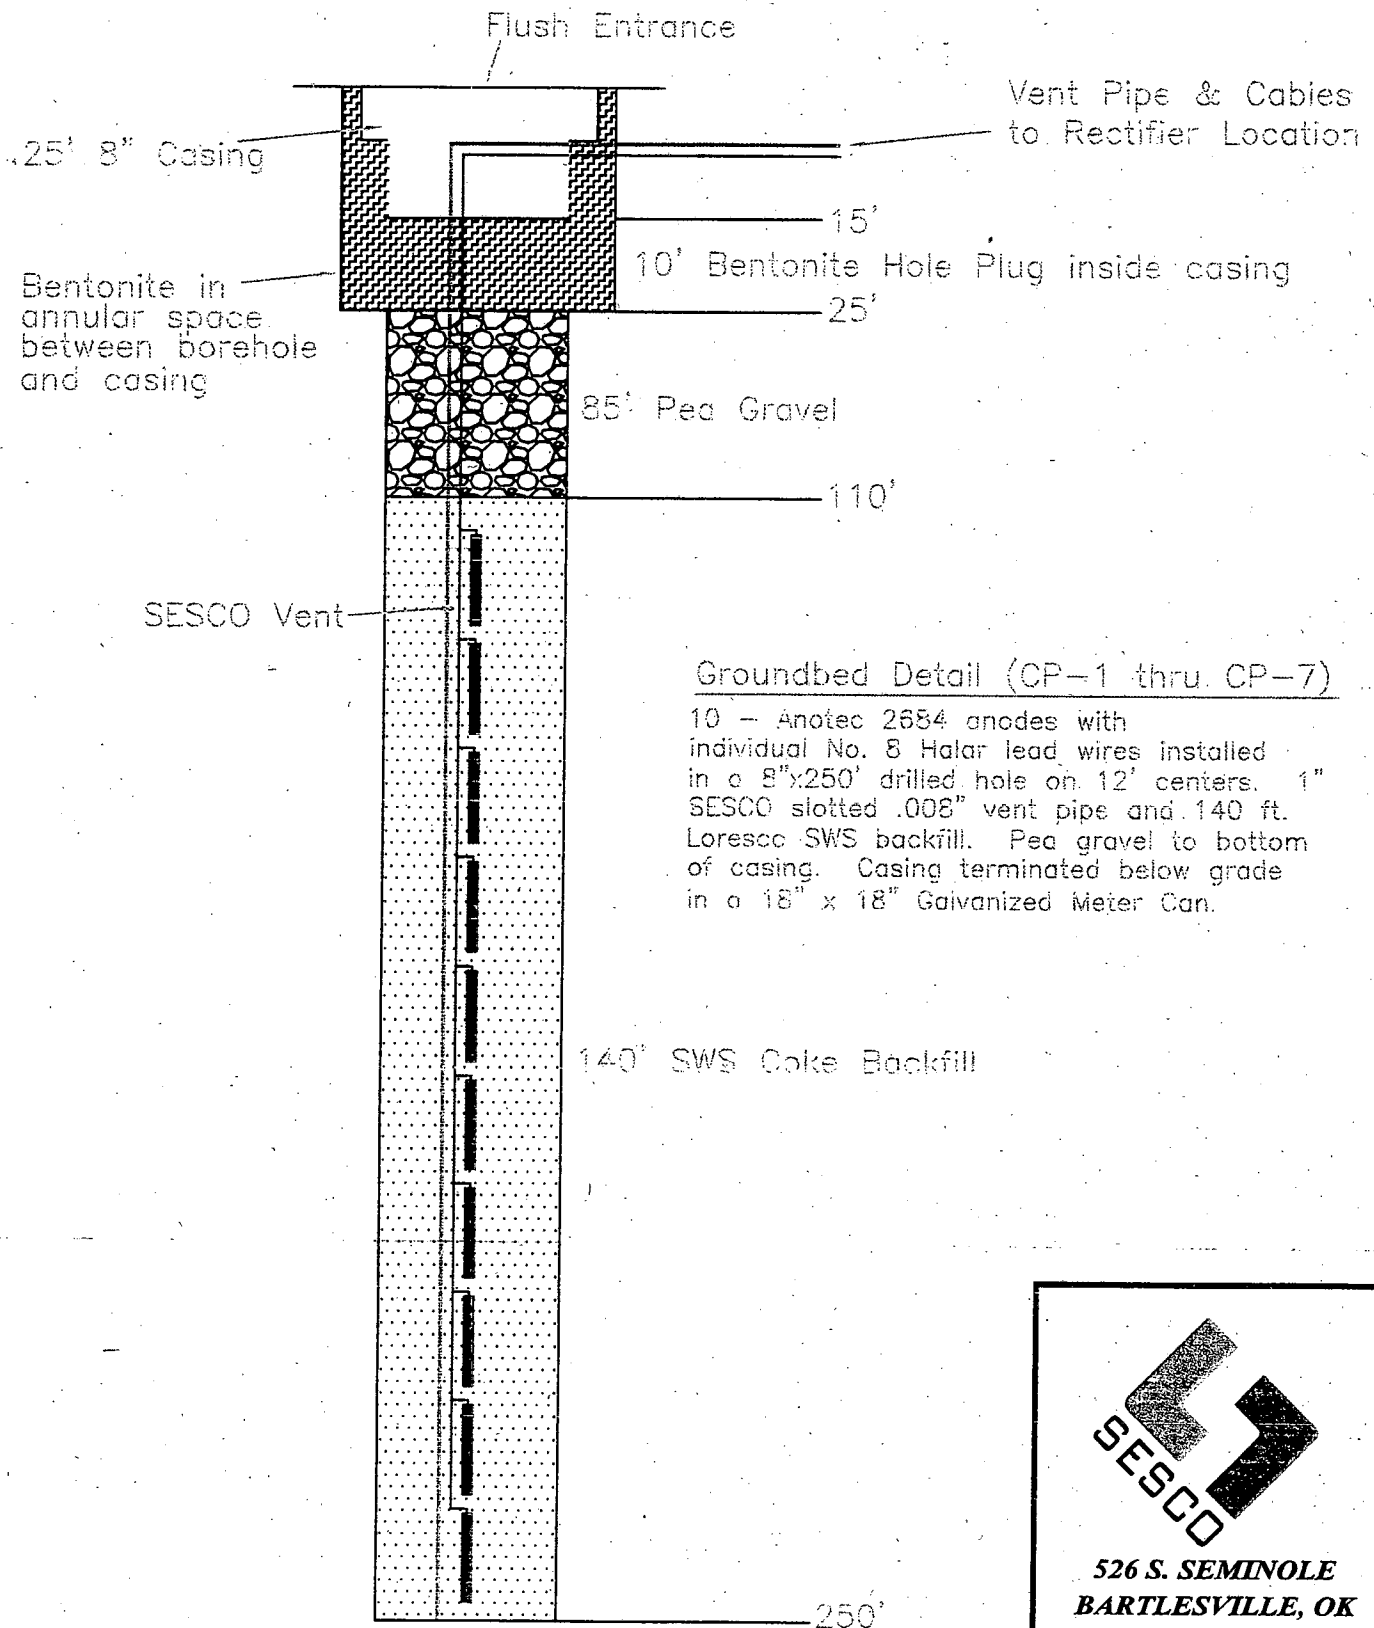

526 S. SEMINOLE
BARTLESVILLE, OK
74003