

15-193-20592-00-00

FOR KCC USE:

FORM C-1 7/91
FORM MUST BE TYPED
FORM MUST BE SIGNED
ALL BLANKS MUST BE FILLED

EFFECTIVE DATE: 3-15-92
DISTRICT # 4
SGA? Yes No

State of Kansas
NOTICE OF INTENTION TO DRILL

Must be approved by the K.C.C. five (5) days prior to commencing well

Expected Spud Date March 11 1992
month day year

Spot C. W/2 S.W/4 Sec 9 Twp 10 S, Rg 31 East
XX West

OPERATOR: License # 9482
Name: National Petroleum Reserves, Inc.
Address: 250 N. Rock Rd., Ste. 340
City/State/Zip: Wichita, KS, 67206
Contact Person: Ted C. Bredehoft
Phone: (316) 681-3515

1320' feet from South / North line of Section
660' feet from East / West line of Section
IS SECTION X REGULAR IRREGULAR?

CONTRACTOR: License #: undetermined
Name: undetermined

(NOTE: Locate well on the Section Plat on Reverse Side)
County: THOMAS
Lease Name: ROBBEN Well #: 2
Field Name: UnNamed

Well Drilled For: Well Class: Type Equipment:
X Oil ... Enh Rec ... Infield X Mud Rotary
... Gas ... Storage X Pool Ext. ... Air Rotary
... OWVO ... Disposal ... Wildcat ... Cable
... Seismic: ... # of Holes ... Other
... Other
If OWVO: old well information as follows:
Operator: undetermined
Well Name: undetermined
Comp. Date: undetermined Old Total Depth undetermined

Is this a Prorated/Spaced Field? ... yes X no
Target Formation(s): LKC, Marm, Miss
Nearest lease or unit boundary: 660'
Ground Surface Elevation: E 3020 feet MSL
Water well within one-quarter mile: ... yes X no
Public water supply well within one mile: ... yes X no
Depth to bottom of fresh water: 150'
Depth to bottom of usable water: 1720'
Surface Pipe by Alternate: ... 1 X 2
Length of Surface Pipe Planned to be set: 300'
Length of Conductor pipe required: undetermined
Projected Total Depth: 4,700'
Formation at Total Depth: Miss
Water Source for Drilling Operations:
... well X farm pond ... other

Directional, Deviated or Horizontal wellbore? ... yes X no
If yes, true vertical depth: undetermined
Bottom Hole Location: undetermined

DWR Permit #: undetermined
Will Cores Be Taken?: ... yes X no
If yes, proposed zone: undetermined

AFFIDAVIT

The undersigned hereby affirms that the drilling, completion and eventual plugging of this well will comply with K.S.A. 55-101, et. seq.
It is agreed that the following minimum requirements will be met:

1. Notify the appropriate district office prior to spudding of well;
2. A copy of the approved notice of intent to drill shall be posted on each drilling rig;
3. The minimum amount of surface pipe as specified below shall be set by circulating cement to the top; in all cases surface pipe shall be set through all unconsolidated materials plus a minimum of 20 feet into the underlying formation;
4. If the well is dry hole, an agreement between the operator and the district office on plug length and placement is necessary prior to plugging;
5. The appropriate district office will be notified before well is either plugged or production casing is cemented in;
6. IF AN ALTERNATE II COMPLETION, PRODUCTION PIPE SHALL BE CEMENTED FROM BELOW ANY USABLE WATER TO SURFACE WITHIN 120 DAYS OF SPUD DATE. IN ALL CASES, NOTIFY DISTRICT OFFICE PRIOR TO ANY CEMENTING.

I hereby certify that the statements made herein are true and to the best of my knowledge and belief.

Date: 2/21/92 Signature of Operator or Agent [Signature] Title: President

FOR KCC USE:
API # 15- 193-20,592
Conductor pipe required None feet
Minimum surface pipe required 300 feet per Alt. ②
Approved by: [Signature] 3-10-92
This authorization expires: 9-10-92
(This authorization void if drilling not started within 6 months of effective date.)
Spud date: _____ Agent: _____

REMEMBER TO:

- File Drill Pit Application (form COP-1) with Intent to Drill;
- File Completion Form ACO-1 within 120 days of spud date;
- File acreage attribution plat according to field proration orders;
- Notify appropriate district office 48 hours prior to workover or re-entry;
- Submit plugging report (CP-4) after plugging is completed;
- Obtain written approval before disposing or injecting salt water.

Mail to: Conservation Division, 200 Colorado Derby Building, 202 W. First St., Wichita, Kansas 67202-1286.

RECEIVED
CORPORATION SERVICES
MAR 10 1992
CONSERVATION DIV
Wichita, Kansas
9
10
314

IN ALL CASES PLOT THE INTENDED WELL ON THE PLAT BELOW

PLAT OF ACREAGE ATTRIBUTABLE TO A WELL IN A PRORATED OR SPACED FIELD

If the intended well is in a prorated or spaced field, please fully complete this side of the form. If the intended well is in a prorated or spaced field complete the plat below showing that the well will be properly located in relationship to other wells producing from the common source of supply. Please show all the wells within 1 mile of the boundaries of the proposed acreage attribution unit for gas wells and within 1/2 mile of the boundaries of the proposed acreage attribution unit for oil wells.

API NO. 15- _____
 OPERATOR National Petroleum Reserves, Inc.
 LEASE ROBBEN
 WELL NUMBER 2
 FIELD OTTLEY NORTH

LOCATION OF WELL: COUNTY THOMAS
 _____ feet from south/north line of section
1320'
 _____ feet from east/west line of section
660'
 SECTION 9 TWP 10S RG 31W



NUMBER OF ACRES ATTRIBUTABLE TO WELL 10
 QTR/QTR/QTR OF ACREAGE _____

IS SECTION X REGULAR or _____ IRREGULAR
 IF SECTION IS IRREGULAR, LOCATE WELL FROM NEAREST
 CORNER BOUNDARY.

Section corner used: _____ NE _____ NW _____ SE _____ SW

PLAT

(Show location of the well and shade attributable acreage for prorated or spaced wells.)
 (Show footage to the nearest lease or unit boundary line.)

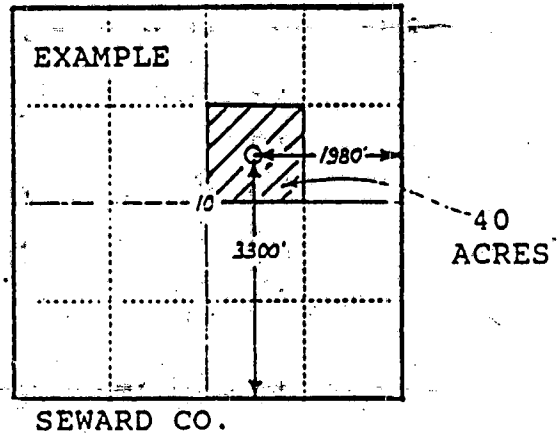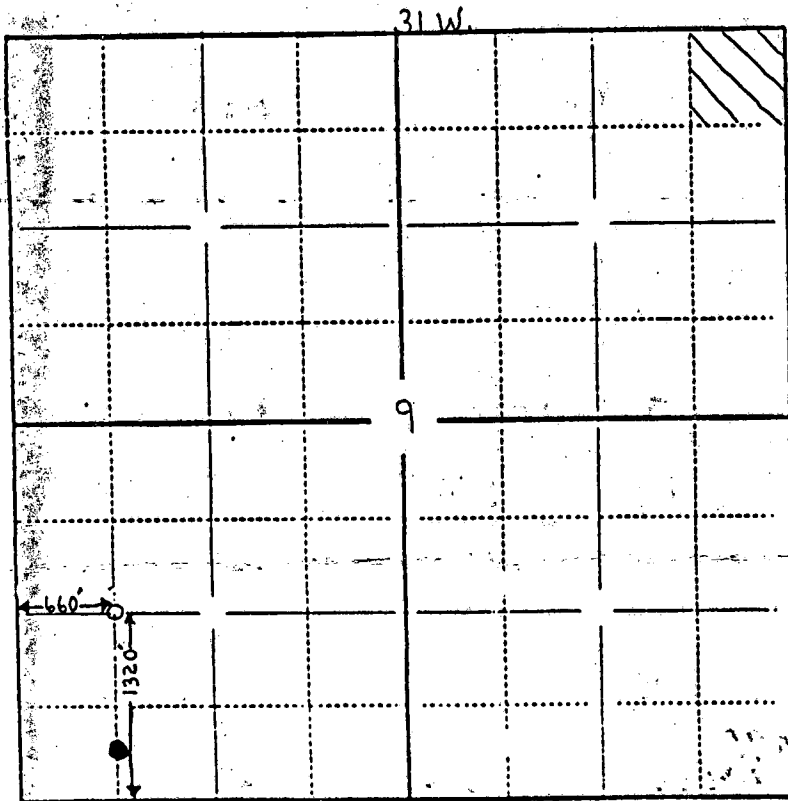

In plotting the proposed location of the well, you must show:

- 1) The manner in which you are using the depicted plat by identifying section lines, i.e. 1 section, 1 section with 8 surrounding sections, 4 sections, etc.;
- 2) the distance of the proposed drilling location from the section's south/north and east/west lines; and
- 3) the distance to the nearest lease or unit boundary line.