

CARD MUST BE TYPED

State of Kansas
NOTICE OF INTENTION TO DRILL
(see rules on reverse side)

CARD MUST BE SIGNED

Starting Date: July 29 1985
month day year

API Number 15-

193-20,363-00-00

OPERATOR: License # 4058
Name American Warrior, Inc.
Address Hiway 50 West
City/State/Zip Garden City, KS 67846
Contact Person Cecil Obrate
Phone 316 275 7461

APP. NW SW NE Sec 14 Twp 10 S, Rge 31
(location) East West

3630 Ft North from Southeast Corner of Section
2610 Ft West from Southeast Corner of Section
(Note: Locate well on Section Plat on reverse side)

CONTRACTOR: License # 4083
Name Western Kansas Drilling
City/State 1111 E. 30th, Box 126, Hays, KS 67601

Nearest lease or unit boundary line 330 feet.
County Thomas
Lease Name Haverkamp Well# 1

Domestic well within 330 feet: yes no
Municipal well within one mile: yes no

Well Drilled For: Well Class: Type Equipment:
 Oil Swd Infield Mud Rotary
 Gas Inj Pool Ext. Air Rotary
 OWWO Expl Wildcat Cable

Depth to Bottom of fresh water 200 feet
Lowest usable water formation ~~Permian~~ DAKOTA
Depth to Bottom of usable water 300 ~ 1750 feet
Surface pipe by Alternate: 1 2

If OWWO: old well info as follows:
Operator
Well Name
Comp Date Old Total Depth
Projected Total Depth 4650 feet
Projected Formation at TD Mississippian Chert
Expected Producing Formations

Surface pipe to be set 300 feet
Conductor pipe if any required feet
Ground surface elevation feet MSL
This Authorization Expires 1-24-86
Approved By R. H. 7-24-85

I certify that we will comply with K.S.A. 55-101, et seq., plus eventually plugging hole to K.C.C. specifications.

Date 7/24/85 Signature of Operator or Agent Elaine Barham Title as agent

STATE CODE

7-24-85

085


PERMISSION.

Must be filed with the K.C.C. five (5) days prior to commencing well
This card void if drilling not started within six (6) months of date received by K.C.C.

CONSERVATION DIVISION
Wichita, Kansas

Important procedures to follow:

**A Regular Section of Land
1 Mile = 5,280 Ft.**

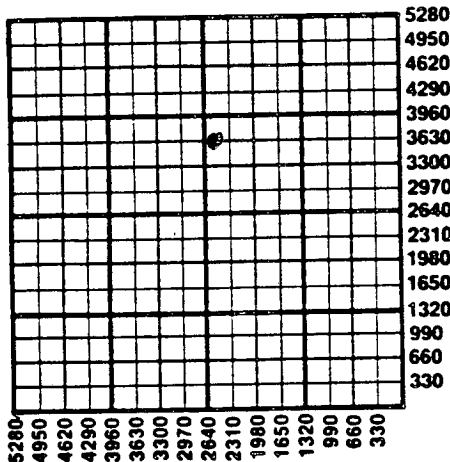

1. Notify District office before setting surface casing.
2. Set surface casing by circulating cement to the top.
3. File completion forms ACO-1 with K.C.C. within 90 days of well completion, following instructions on ACO-1, side 1, and including copies of wireline logs.
4. Notify District office 48 hours prior to old well workover or re-entry.
5. Prior to plugging, prepare a plugging plan, then obtain agreement from the appropriate district office for an approved plugging plan.
6. Submit plugging report (CP-4) to K.C.C. after plugging is completed.
7. Obtain an approved injection docket number before disposing of salt water.
8. Notify K.C.C. within 10 days when injection commences or terminates.
9. If an alternate 2 completion, cement in the production pipe from below any usable water to surface within 120 days of spud date.

State Corporation Commission of Kansas
Conservation Division
200 Colorado Derby Building
Wichita, Kansas 67202

(316) 263-3338