

NOTICE OF INTENTION TO DRILL

(see rules on reverse side)

Starting Date Oct. 20, 1986
month day year 3:55

API Number 15- 193-20, 417-00-00

OPERATOR: License # 9041
Name Joseph H. Strabala
Address 312 W. Uintah St.
City/State/Zip ... Colo. Springs, CO. 80903
Contact Person.. Joseph
Phone..... 303. 635. 7807. ~~25~~

_____ East
appSW SE SW Sec..... 13 Twp... 10 S, Rg... 31... West
..... 330 Ft. from South Line of Section
..... 3700 Ft. from East Line of Section

(Note: Locate well on Section Plat on reverse side)

CONTRACTOR: License # 4083
Name Western Kansas Drilling, Inc.
City/State Hays, Kansas 67601

Nearest lease or unit boundary line . 330 feet
County..... Thomas

Lease Name.. Hulsman Well # 1
Ground surface elevation ... 2090 feet MSL

Well Drilled For: Well Class: Type Equipment:
X Oil SWD Infield Mud Rotary
 Gas Inj Pool Ext. Air Rotary
 OWWO Expl Wildcat Cable

Domestic well within 330 feet: _____ yes no
Municipal well within one mile: _____ yes no

If OWWO: old well info as follows:

Depth to bottom of fresh water..... 180
Depth to bottom of usable water ~~2500~~ 1700

Operator
Well Name
Comp Date Old Total Depth.....

Surface pipe by Alternate: _____ 1 2 KLL
Surface pipe planned to be set 200 230

I certify that well will comply with K.S.A. 55-101, et seq., plus eventually plugging hole to KCC specifications.

Conductor pipe required n/a
Projected Total Depth 4550 feet
Formation..... Miss. - Lansing - KC

Date 10-20-86. Signature of Operator or Agent *Nona Elmore* Title..... as agent

For KCC Use:


Conductor Pipe Required feet; Minimum Surface Pipe Required 230 feet per Alt. 40
This Authorization Expires 4-20-87 Approved By 10-20-86 *[Signature]* 2

Must be filed with the K.C.C. five (5) days prior to commencing well
This card void if drilling not started within six (6) months of date received by K.C.C.

Important procedures to follow:

1. Notify District office before setting surface casing.
2. Set surface casing by circulating cement to the top.
3. File completion forms ACO-1 with K.C.C. within 90 days of well completion, following instructions on ACO-1, side 1, and including copies of wireline logs.
4. Notify District office 48 hours prior to old well workover or re-entry.
5. Prior to filing Intent, prepare a proposed plugging plan in case well is D & A, then obtain approval of plan when calling district office prior to setting surface pipe.
6. Submit plugging report (CP-4) to K.C.C. after plugging is completed.
7. Obtain an approved injection docket number before disposing of salt water.
8. Notify K.C.C. within 10 days when injection commences or terminates.

**A Regular Section of Land
1 Mile = 5,280 Ft.**

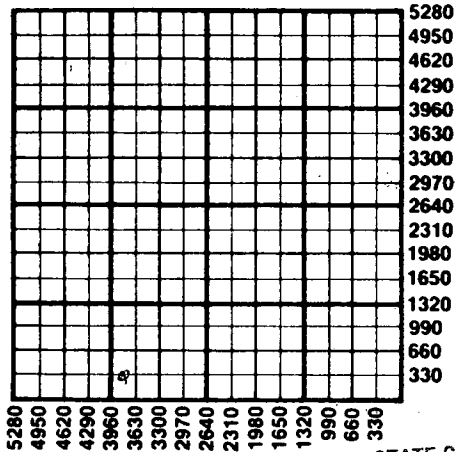

RECEIVED
STATE CORPORATION COMMISSION

OCT 20 1986

CONSERVATION DIVISION
Wichita, Kansas

If an alternate 2 completion, cement in the production pipe from below any usable water to surface within 120 days of spud date.

State Corporation Commission of Kansas
Conservation Division
200 Colorado Derby Building
Wichita, Kansas 67202
(316) 263-3238