


Kansas Corporation Commission Oil & Gas Conservation Division

WELL PLUGGING APPLICATION

Please TYPE Form and File ONE Copy

Form CP-1 September 2003 This Form must be Typed Form must be Signed All blanks must be Filled

API # 15 - 095-00613 - 0-0	(Identifier Number of this we	ell). This must be listed for wells drill	led since 1967; if no API # was issued,	
indicate original spud or completion date 9/26/4	3			
Well Operator: PETROLEUM PROPERTY SERVICES, INC		KCC License #: 31142		
(Owner / Company Name)		City: WICHITA		
	Zip Code: 67202		265 - 3351	
			S. R. 8 East	
SW - SW - NW -		unty: KINGMAN		
2020	North / South (from ne		Section (Not Lease Line)	
330 4950 Feet (in exact footage) From		earest outside section corner) Line of s		
Check One: Oil Well Gas Well	D&A Cathodic	Water Supply Well	,	
SWD Docket # G-7256 D-	/		ther:	
Conductor Casing Size:	Set at:	Cemented with:	Sacks	
Surface Casing Size: 10-3/4	Set at: 328	Cemented with: 200 Sacks		
Production Casing Size: 5-1/2	Set at: 4667	Cemented with: 400 Sacks		
List (ALL) Perforations and Bridgeplug Sets: OF	PEN HOLE: 4667-4819'			
Condition of Well: Good Pool Proposed Method of Plugging (attach a separate page)		Junk in Hole ER KCC INSTRUCTIONS	RECEIVED MAR 0 4 2009	
Is Well Log attached to this application as required If not explain why? BEFORE ACO-1	? 🗸 Yes 🗌 No Is ACO-1 fil	led? Yes 🗸 No	KCC WICHITA	
Plugging of this Well will be done in accordance List Name of Company Representative authorized		ions: LEON KUHN		
Address: P O BOX 551		Thome.	· 1559	
		City / State: RUSSELL, KS 67665		
(Company Name)		KCC License #: 32970 (Contractor's) Rhope (785) 389 - 2289		
Address: P O BOX 87, BAZINE KS	AS SOON AS DIG IS AVAI	Phone: (785) 389	- 2203	
Proposed Date and Hour of Plugging (if known?):				
Payment of the Plugging Fee (K.A.R. 82-3-118) v Date: 3/3/09 Authorized Operato)		
Mail to: KCC - Cor	nservation Division, 130 S. Mark	/ (Signature) et - Room 2078, Wichita, Kansas	s 67202	

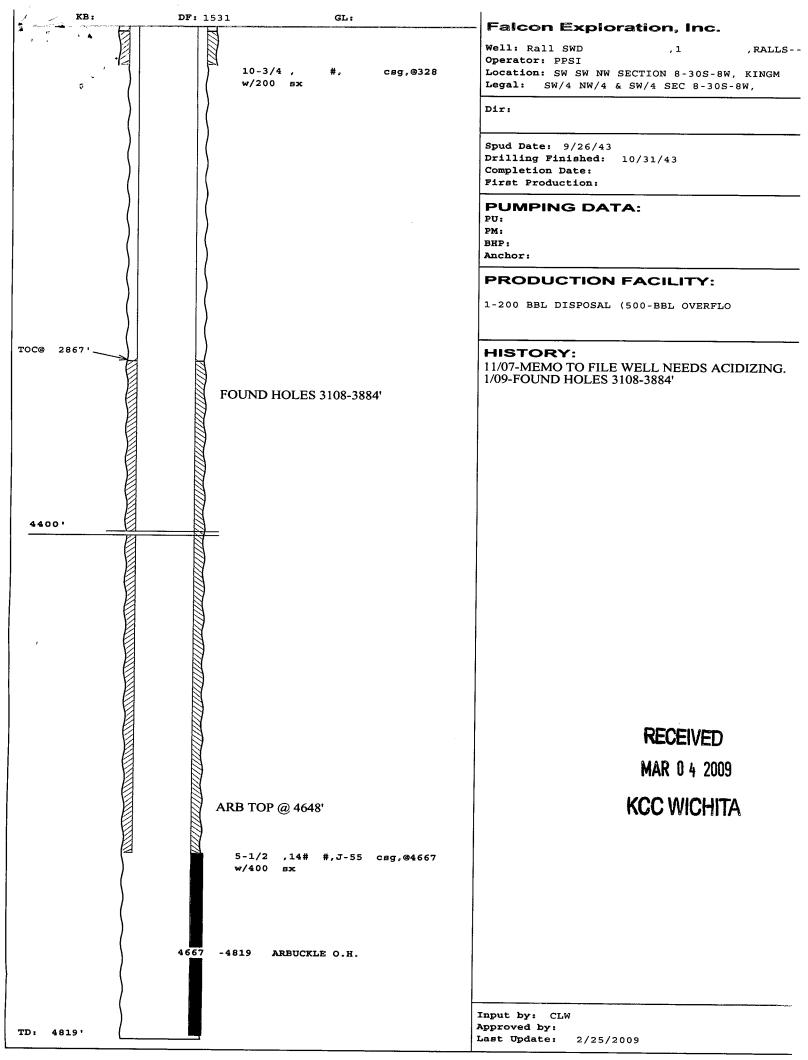



Kathleen Sebelius, Governor Thomas E. Wright, Chairman Michael C. Moffet, Commissioner Joseph F. Harkins, Commissioner

NOTICE OF RECEIPT OF WELL PLUGGING APPLICATION (CP-1)

PETROLEUM PROPERTY SERVICES, INC. 125 N MARKET SUITE 1251 WICHITA, KS 67202-1719 March 09, 2009

Re: RALL #1

API 15-095-00613-00-01

8-30S-8W, 2970 FSL 4950 FEL KINGMAN COUNTY, KANSAS

Dear Operator:

This letter is to notify you that the Conservation Division has received your plugging proposal, form CP-1, for the above well and has reviewed the proposal for completeness. The central office will now forward your CP-1 to the district office listed below for review of the proposed plugging method. Please contact the district office for approval of your proposed plugging method at least five (5) days before plugging the well, pursuant to K.A.R. 82-3-113(b). If a workover pit will be used during the plugging of the well it must be permitted. A CDP-1 form must be filed and approved prior to the use of the pit in accordance with K.A.R. 82-3-600.

The Conservation Division's review of form CP-1, either in the central or district office, does not include an inquiry into well ownership or the filing operator's legal right to plug the well. This notice in no way constitutes authorization to plug the above well by persons not having legal rights of ownership or interest in the well.

This notice is void after September 5, 2009. The CP-1 filing does not bring the above well into compliance with K.A.R. 82-3-111 with regard to the Commission's temporary abandonment requirements.

Sincerely,

Steve Bond

Steve Bond

Production Department Supervisor

District: #2

3450 N. Rock Road, Suite 601

Wichita, KS 67226

(316) 630-4000