


15-065-00428-00-00

WELL PLUGGING RECORD

Give All Information Completely  
Make Required Affidavit  
Mail or Deliver Report to:  
Conservation Division  
State Corporation Commission  
800 Bitting Building  
Wichita, Kansas

NORTH

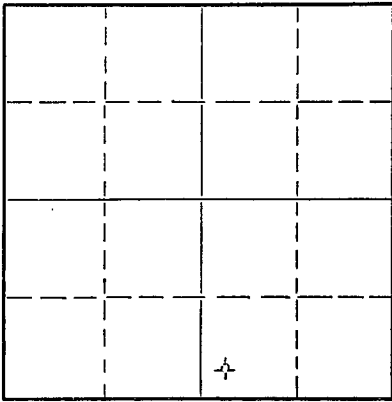

Locate well correctly on above Section Plat

Graham County. Sec. 10 Twp. 10S Rge. 23 (E) W (W)  
Location as "NE/CNW/SW" or footage from lines SW/4 SW/4 SE/4  
Lease ~~Owner~~ Operator: Birmingham-Bartlett Drilling Co.  
Lease Name Johnson "C" Well No. 1  
Office Address 300 Kaufman Bldg., Wichita, Kansas  
Character of Well (completed as Oil, Gas or Dry Hole) Dry Hole  
Date well completed March 16, 19 54  
Application for plugging filed (Verbal Approval recd) March 17, 19 54  
Application for plugging approved (Verbal) March 17, 19 54  
Plugging commenced March 17, 19 54  
Plugging completed March 17, 19 54  
Reason for abandonment of well or producing formation Dry Hole

If a producing well is abandoned, date of last production 19  
Was permission obtained from the Conservation Division or its agents before plugging was commenced? Yes

Name of Conservation Agent who supervised plugging of this well Eldon Petty  
Producing formation \_\_\_\_\_ Depth to top \_\_\_\_\_ Bottom \_\_\_\_\_ Total Depth of Well 4205 Feet  
Show depth and thickness of all water, oil and gas formations.

OIL, GAS OR WATER RECORDS

CASING RECORD

FORMATION	CONTENT	FROM	TO	SIZE	PUT IN	PULLED OUT
		0	239'	8 5/8"	239'	none

Describe in detail the manner in which the well was plugged, indicating where the mud fluid was placed and the method or methods used in introducing it into the hole. If cement or other plugs were used, state the character of same and depth placed, from \_\_\_\_\_ feet to \_\_\_\_\_ feet for each plug set.

15 sacks cement on bottom. Plug set at 220'.  
10 sacks cement on top. plug set at 40'.  
Filled with mud to surface.

03-23-1954


(If additional description is necessary, use BACK of this sheet)  
Name of Plugging Contractor Birmingham-Bartlett Drilling Co.  
Address 300 Kaufman Bldg., Wichita 2, Kansas

STATE OF Kansas COUNTY OF Sedgwick  
Richard Hindery, partner, Birmingham-Bartlett Drilling Co., <sup>ss.</sup> operator  
well, being first duly sworn on oath, says: That I have knowledge of the facts, statements, and matters herein contained and the log of the above-described well as filed and that the same are true and correct. So help me God. BIRMINGHAM-BARTLETT DRILLING CO.  
(Signature) By Richard Hindery Partner  
300 Kaufman Bldg., Wichita 2, Kansas (Address)

SUBSCRIBED AND SWORN TO before me this 22nd day of March, 19 54

My commission expires October 2, 1954  
Beverly Larson  
Notary Public.

24-7368-S 3-53-20M

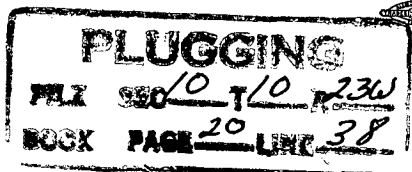

15-065-00428-00-00

JOHNSON "C" NO. 1 WELL

LOCATION: SW/4 SW/4 SE/4  
Section 10-109-23W  
Graham County, Kansas  
SPUDED: 3-3-54  
COMPLETED: 3-16-54

OPERATOR and CONTRACTOR: Birmingham-Bartlett Drilling Co.  
300 Kaufman Building  
Wichita 2, Kansas

SURFACE CASING: 8 5/8" casing cemented at 239' with  
175 sacks cement and 2 cc.

OIL STRING: None set. D & A

REC'D  
MAR 23 1954  
CON. 03-23-1954  
DIVISION  
Wichita, Kansas

LOG

(Figures indicate bottom of formation)

0	155	Clay and shale
	239	Shale
	1385	Shale and shells
	1425	Shale and sand
	1650	Sand
	1920	Shale and shells
	1965	Anhydrite
	2525	Shale and shells
	3470	Lime and shale
	4000	Lime
	4110	Lime and shale
	4140	Shale and chert
	4163	Chert
	4185	Shale and chert
	4205	Lime
	4205	RTD - D & A

The undersigned, Richard Hindery, one of the partners of Birmingham-Bartlett Drilling Co., hereby certifies that the above is a true and correct log of the formations encountered in drilling the Johnson "C" No. 1 Well as shown in the daily drilling reports.

BIRMINGHAM-BARTLETT DRILLING CO.

By Richard Hindery

Subscribed and sworn to before me  
this 18th day of March, 1954.

Beverly Harrison  
Notary Public

My commission expires October 2, 1954

PLUGGING

FILE SEC 10 10 23W  
BOOK PAGE 20 LINE 38

