


Give All Information Completely
Make Required Affidavit
Mail or Deliver Report to:
Conservation Division
State Corporation Commission
211 No. Broadway
Wichita, Kansas

WELL PLUGGING RECORD

NORTH

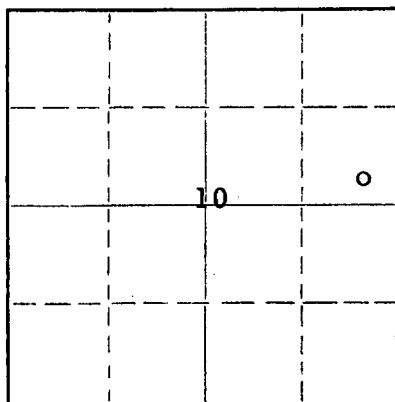

Locate well correctly on above
Section Plat

Graham County. Sec. 10 Twp. 10 Rge. (E) 23 (W)
Location as "NE/CNWxSWx" or footage from lines SE SE NE
Lease Owner Burch Drilling Co., Inc.
Lease Name Law Well No. 1
Office Address 1011 Union Center - Wichita, Kansas
Character of Well (completed as Oil, Gas or Dry Hole) dry hole
Date well completed 8-29 1957
Application for plugging filed 8-29 1957
Application for plugging approved 8-29 1957
Plugging commenced 8-29 1957
Plugging completed 8-29 1957
Reason for abandonment of well or producing formation dry

If a producing well is abandoned, date of last production 19
Was permission obtained from the Conservation Division or its agents before plugging was commenced? yes

Name of Conservation Agent who supervised plugging of this well Eldon Petty
Producing formation _____ Depth to top _____ Bottom _____ Total Depth of Well 4163 Feet
Show depth and thickness of all water, oil and gas formations.

OIL, GAS OR WATER RECORDS

CASING RECORD

FORMATION	CONTENT	FROM	TO	SIZE	PUT IN	PULLED OUT
				8 5/8	210	none

Describe in detail the manner in which the well was plugged, indicating where the mud fluid was placed and the method or methods used in introducing it into the hole. If cement or other plugs were used, state the character of same and depth placed, from _____ feet to _____ feet for each plug set.

Set 1st plug @ 600' w/20 sx. cement.
Set 2nd plug @ 200' w/20 sx. cement.
Set 3rd plug @ 40' w/10 sx. cement.

(If additional description is necessary, use BACK of this sheet)

Name of Plugging Contractor Burch Drilling Co., Inc.
Address 1011 Union Center - Wichita, Kansas


STATE OF Kansas, COUNTY OF Sedgwick, ss.
Earl M. Burch (employee of owner) or (owner or operator) of the above-described well, being first duly sworn on oath, says: That I have knowledge of the facts, statements, and matters herein contained and the log of the above-described well as filed and that the same are true and correct. So help me God.

(Signature) Earl M Burch

(Address)

September, 1957.

Betty Spragg
Notary Public.

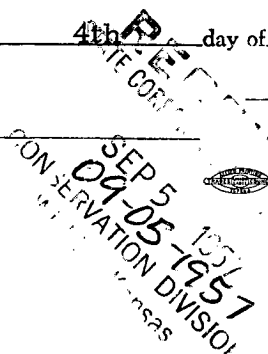

PLUGGING
FILE SEC 10 T 10 R 23W
BOOK PAGE 41 LINE 90

15-065-00953-00-00

DRILLERS LOG

Burch Drilling Co., Inc.

Comm: 8-16-57
Comp: 8-29-57
8 5/8" @ 210' w/150 sx.

LAW #1
SE SE NE 10-10S-23W,
Graham County, Kansas

Elevation: 2380' KB
D & A

Tops:

1285	Shale & Shells		
1840	Red Bed, Shale & Lime streaks	Heebner	3644
2119	Lime & Shale	Toronto	3666
2137	Shale	Lansing	3682
2325	Shale & Lime streaks	BKC	3902
3510	Shale & Lime	Marmaton chert	4002
3590	Lime & Shale streaks	Cherty Conglomerate	4133
3712	Lime & Shale	RTD	4163
3975	Lime		
4066	Cherty Shale & Lime		
4163	Lime & Shale		
4163	RTD		

3682
2380
 -1302

State of Kansas, County of Sedgwick, ss:

I, Earl M. Burch, president of Burch Drilling Co., Inc., owner or operator of the above described well, being first duly sworn on oath, says: That I have knowledge of the facts, statements, and matters herein contained and the log of the above described well as filed and that the same are true and correct.

Earl M. Burch

Subscribed and sworn to before me this 4th day of September, 1957.



My commission expires:
6-13-59.

RECEIVED
STATE OF KANSAS
09-05-1957
CONSERVATION DIVISION
neas

Betty Spragg
Notary Public

PLUGGING			
FILE	SEC 10	T 10	R 23W
BOOK	PAGE 41	LINE 40	