

15-065-03127-00-00

Form CP-4 *Sec*

STATE CORPORATION COMMISSION

Give All Information Completely
Make Required Affidavit
Mail or Deliver Report to:
Conservation Division
State Corporation Commission
211 No. Broadway
Wichita, Kansas

WELL PLUGGING RECORD

Graham County. Sec. 11 Twp. 10S Rge. (E) 23 (W)

Location as "NE/CNW/SW" or footage from lines. SW/4 SW/4 SW/4

Lease Owner Skelly Oil Company

Lease Name Griffith "A" Well No. 1

Office Address P. O. Box 1650, Tulsa, Oklahoma

Character of Well (completed as Oil, Gas or Dry Hole) Oil

Date well completed June 11, 19 59

Application for plugging filed December 1, 19 66

Application for plugging approved December 5, 19 66


Plugging commenced December 6, 19 66

Plugging completed December 10, 19 66

Reason for abandonment of well or producing formation Uneconomical to operate

If a producing well is abandoned, date of last production December 2, 19 66

Was permission obtained from the Conservation Division or its agents before plugging was commenced? Yes

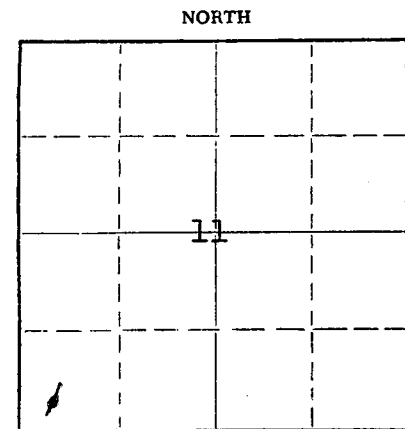

Locate well correctly on above Section Plat

Name of Conservation Agent who supervised plugging of this well Mr. W. L. Nichols

Producing formation Lansing Lime Depth to top 3678' Bottom _____ Total Depth of Well 3961 Feet

Show depth and thickness of all water, oil and gas formations. PB 3690'

OIL, GAS OR WATER RECORDS

CASING RECORD

FORMATION	CONTENT	FROM	TO	SIZE OD	PUT IN	PULLED OUT
Lansing Lime	Oil	3681'	3687'	8-5/8"	242'6"	None
					3989'3"	2826'6"

Describe in detail the manner in which the well was plugged, indicating where the mud fluid was placed and the method or methods used in introducing it into the hole. If cement or other plugs were used, state the character of same and depth placed, from _____ feet to _____ feet for each plug set.

- Sand 3690' to 3650'
- 5^a sacks of cement 3650' to 3610'
- Gelled mud 3610' to 400'
- 65 sacks of cement 400' to 200'
- Gelled mud 200' to 30'
- 10 sacks of cement 30' to Base cellar
- Surface soil Cellar to Surface

RECEIVED
STATE CORPORATION COMMISSION

DEC 29 1966
12-29-1966
CONSERVATION DIVISION
Wichita, Kansas

(If additional description is necessary, use BACK of this sheet)
Name of Plugging Contractor Southwest Casing Pulling Co., Inc.

Address P. O. Box 364, Great Bend, Kansas

STATE OF Nebraska, COUNTY OF Red Willow, ss. C. F. Bass (employee of owner) or (~~owner~~) of the above-described

well, being first duly sworn on oath, says: That I have knowledge of the facts, statements, and matters herein contained and the log of the above-described well as filed and that the same are true and correct. So help me God.

(Signature) C. F. Bass

P. O. Box 649, McCook, Nebraska 69001
(Address)


SUBSCRIBED AND SWORN to before me this 23rd day of December, 19 66

My commission expires June 13, 1969

C. C. Lindsey
Notary Public.

15-065-03127-00-00

SKELLY OIL COMPANY

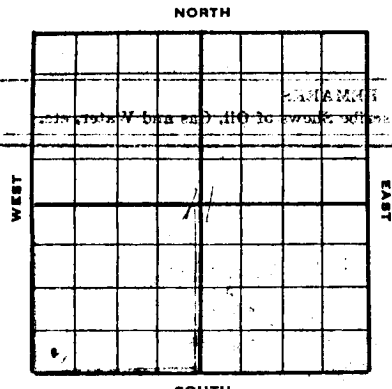

Well No. **39077** Elevation: **2381' DP, 2378' GR, 2377' BH**
 Lease Name and No. **Griffith "A"** Well No. **1**
 Lease Description **SW/4 Section 11-103-23W, Graham County, Kansas (160 Acres)**
 Location made **May 2, 1959** by **E. S. Tessler**
 feet from North line **330** feet from East line **330**
 feet from South line **330** feet from West line of **Sec. 11**
 Work com'd **5/10 1959** Rtg. comp'd **5/11 1959** Drlg. com'd **5/11 1959** Drlg. comp'd **5/26 1959**

Rig Contractor **Claude Wentworth Drlg. Co., Inc.**
 Drilling Contractor **Claude Wentworth Drlg. Co., Inc., Tulsa, Okla.**
 Rotary Drilling from **0'** to **3961'** Cable Tool Drilling from **To complete** to **10 COPE**
 Commenced Producing **June 11, 1959** Initial Prod. before shot or acid **10 COPE** Bbls.
 Initial Prod. after shot or acid **FOE 8 hrs. 614 BO and 8.35 BO to total. 24 hr. 500 potential of 184 barrels.** Bbls.
 Dry Gas Well Press. **184 barrels.** Volume Cu. ft.
 Casing Head Gas Pressure **8-5/8" x 5 1/2" OD** Volume Cu. ft.
 Braden Head (**8-5/8" x 5 1/2" OD**) Gas Pressure Volume Cu. ft.
 Braden Head (**Size**) Gas Pressure Volume Cu. ft.
 PRODUCING FORMATION **Lansing Lina** Top **3681'** Bottom **3687'** TOTAL DEPTH **3961'** PB **3690'**

CASING RECORD

OD Size	Wt.	Thds.	Where Set	PULLED OUT			LEFT IN			KIND	Cond'n	CEMENTING	
				Jts.	Feet	In.	Jts.	Feet	In.			Sacks Used	Method Employed
8-5/8"	22.73	247'					6	247'	6	Armed SW A	A	165	Hallib. 243'
5-1/2"	14.8	3960'					139	3989'	3	J55 R2 SW A	A	200	Hallib. 3957'
(8-5/8" casing cut off 1' below ground level, and 5 1/2" cut off at ground level)													
5 1/2" casing perforations open													
Above PB 10: 3681'-3687' with 36 holes													
Below PB 10: 3839'-3848' with 28 holes, 3857'-3862' with 20 holes													

Liner Set at _____ Length _____ Perforated at _____
 Liner Set at _____ Length _____ Perforated at _____
 Packer Set at _____ Size and Kind _____
 Packer Set at _____ Size and Kind _____

SHOT OR ACID TREATMENT RECORD

	FIRST	SECOND	THIRD	FOURTH
Date	6/5/59	6/6/59	6/7/59	6/10/59
Acid Used	500 Gals. OX	500 Gals. OX	500 Gals. OX	500 Gals. OX
Shot Between	3857 Ft. and 3862 Ft.	3839 Ft. and 3846 Ft.	3692 Ft. and 3700 Ft.	3681 Ft. and 3687 Ft.
Size of Shell	IX-38	IX-38	IX-38	IX-38
Put in by (Co.)	Dowell Inc.	Dowell Inc.	Dowell Inc.	Dowell Inc.
Length anchor				
Distance below Cas'g				
Damage to Casing or Casing Shoulder				

SIGNIFICANT GEOLOGICAL FORMATIONS

NAME	Top	Bottom	GAS		OIL		REMARKS
			From	To	From	To	
Topoka Lina	3426'						
Heubner Shale	3640'						
Toronto Lina	3664'						
Lansing Lina	3678'				3681'	3687'	Prod. thru cas. perforations

CLEANING OUT RECORDS

	DATE COMMENCED	DATE COMPLETED	PROD. BEFORE	PROD. AFTER	REMARKS
1st					See Reverse for other details.
2nd					" " " " "
3rd					" " " " "
4th					" " " " "

PLUGGING BACK AND DEEPENING RECORDS

	Date Commenced	Date Completed	No. Feet Plugged Back or Deepened	Prod. Before	Prod. After	REMARKS
1st						See Reverse for other details.
2nd						" " " " "
3rd						" " " " "
4th						" " " " "

(See Reverse for Record of Formation)

RECORD OF FORMATIONS

FORMATION	TOP	BOTTOM	REMARKS Indicate Casing Points, Describe Shows of Oil, Gas and Water, etc.
Surface soil and clay	0	40	
Shale and sand	40	200	
Shale	200	248	Set and cemented 8-5/8" OD, 22.7#, Arco S.W., S.J. steel casing (A cond.) at 247' with 165 sacks of Pozmix cement and 2% calcium chloride. Cement circulated. Finished midnight 5/11/59.
Shale and shells	248	1200	
Sand	1200	1270	
Shale and shells	1270	1465	
Sand	1465	1640	
Red bed	1640	1955	
Anhydrite	1955	1967	
Shale	1967	2245	
Shale and shells	2245	2395	
Shale	2395	2410	
Shale and lime	2410	3650	
Lime	3650	3681	TOP TOPEKA LINE 3626' TOP BELLEFIER SHALE 3640' TOP TORONTO LINE 3664' TOP LANSING LINE 3678'
Lime, white, finely crystalline, good vuggy porosity with trace of light stain, slight show of oil	3681	3686	
Lime	3686	3698	San Halliburton drill stem test No. 1, packer set at 3666', used 32' anchor, open 1 hour, strong blow throughout test, recovered 300' of gas, 185' of heavily oil and gas cut mud, 300' of free oil (38 gravity at 60°), IHHP-1225% in 20 mins., IFF-40%, FFP-210%, FHHP-1170% in 20 mins.
Lime	3698	3758	
Lime, light gray, finely crystalline, slightly oolitic to fair vuggy porosity, spotted oil stain, show of live oil	3758	3760	
Lime	3760	3764	San Halliburton drill stem test No. 2, packer set at 3752', used 12' anchor, open 1 hour, weak blow for 5 mins., recovered 35' of fair oil cut mud, IHHP-105% in 20 mins., IFF-0%, FFP-0%, FHHP-105% in 20 minutes.
Lime, tan, crypto-crystalline to fine crystalline, slight vuggy porosity, light oil stain	3764	3772	
Lime	3772	3778	San Halliburton drill stem test No. 3, packer set at 3768', used 10' anchor, open 1 hour, fair blow throughout test, recovered 330' muddy salt water, no oil, IHHP-1015% in 20 mins., IFF-25%, FFP-135%, FHHP-910% in 20 minutes.
Lime	3778	3818	
Lime, white, fine crystalline, slightly oolitic, fair vuggy porosity, light oil stain	3818	3821	
Lime	3821	3826	
Lime, white fine crystalline, slightly oolitic, fair vuggy porosity, light oil stain	3826	3827	San Halliburton drill stem test No. 4, packer set at 3810', used 17' anchor, open 1 hour, weak blow dead in 4 minutes, recovered 5' of mud, no oil, IHHP-25% in 20 mins., all other pressures 0%.

Line	3827	3842
Line, brown crypto-crystalline, dense, very slight porosity with dead oil	3842	3846
Line	3846	3855
Line, white, fine crystalline, slight porosity and oil stain, trace free oil	3855	3858
Line	3858	3867
Line	3867	3877
Line, white, fine crystalline, fair porosity, black to dead oil stain	3877	3879
Line and shale	3879	3890
Line	3890	3902
Line and shale	3902	3961

Ran Halliburton drill stem test No. 5, packer set at 3847', used 20' anchor, open 1 hour, weak blow, dead in 5 mins., recovered 20' mud, no oil, IBNP-20' in 20 mins., all other pressures 0'.

EASE KANSAS CITY LINE 3900'
TOP WARRATOR SAND 3945'
Ran Schlumberger Surveys.

TOTAL DEPTH 3961'

Total Depth Reached: 5/26/59

Set and cemented 5 1/2" OD, 14# SR thd., R-2, J-55, S.S. casing (A cond.) at 3960' with 200 sacks of SOW cement, opened stage collar at 3370' with 1000#-CP, spotted 160 barrels of heavy oil behind 5 1/2" casing, oil circulated, closed stage collar with 2000#-CP. Finished 3:00 am 5/27/59.

Rigged up cable tools and scrubbed and bailed the hole dry to top of stage collar at 3370' on June 4, and 5 1/2" casing tested dry. Scrubbed hole dry to 3934', top of bottom plug. Ran Lane-Wells Collar Log.

Casing Perforation No. 1 - Lansing Line - 3857'-3862'
3857'-3862' 20 A-2 holes

No shows. Treated through 5 1/2" casing with 500 gallons of Dowell "XM-38", 15% acid as follows:

TREATMENT NO. 1 - Acidized between 3857'-3862'

Treatment put in 6/5/59 by Dowell, using 500 gallons of acid and 96 barrels of oil to fill and flush.

TIME	CP	IP	REMARKS
12:48 pm			Start oil
12:55 pm			Start acid in hole
12:59 pm			Start to fill hole with oil
1:30 pm			Start flush
1:33 pm	300'		
3:00 pm	900'		
3:38 pm	1000'		
4:00 pm	950'		
4:43 pm	725'		Treatment completed

Scrubbed through 5 1/2" casing 4 hours, 92 barrels of oil used in treating, scrubbed to bottom. Bailed and tested 8 hours, approximately 10 gallons of water per hour, trace of treating oil.

Set Lane-Wells bridging plug at 3850', bailed the hole dry, tested dry.

Casing Perforation No. 2 - Lansing Line - 3839' to 3846' with 28 Lane-Wells A-2 holes, no shows.

Treated through 5 1/2" casing with 500 gallons of Dowell "XM-38" acid as follows:

TREATMENT NO. 2 - Acidized between 3839'-3846'

Treatment put in 6/6/59 by Dowell Inc., using 500 gallons acid and 94 barrels oil.

TIME	CP	IP	REMARKS
1:20 pm			Start acid in hole
1:36 pm			Start to fill with oil
2:05 pm	100'		Filled hole with 83 barrels of oil
3:00 pm	800'		
3:10 pm	775'		
3:21 pm	500'		
3:59 pm	700'		Treatment completed

Swabbed through 5 1/2" casing 3 hours, 94 barrels of oil used in treating; then swabbed 4 hours, 12 barrels of water with trace of oil.

Set Lane-Wells bridging plug at 3715'.

Casing Perforation No. 3 - Lansing Line - 3692'-3700'
3692'-3700' 32 holes

II shows. Treated through 5 1/2" casing with 500 gallons of Dowell "XM-38" acid as follows:

TREATMENT NO. 3 - Acidized between 3692' and 3700'

Treatment put in 6/7/59 by Dowell Inc., using 500 gallons of acid and 90 barrels of oil.

TIME	CP	IF	REMARKS
2:50 am			Start acid in hole
3:00 am			Start to fill hole with oil
3:26 am	100%		Filled hole with 79 barrels oil
3:45 am	400%		
5:15 am	600%		
6:32 am	600%		Treatment completed

Swabbed through 5 1/2" casing 2 hours, 90 barrels of oil used in treating. Then swabbed 6 hours, trace of oil with 48 barrels of water.

Ran 2" tubing and set Halliburton DM retainer at 3660'. Cemented out perforations from 3692' to 3700' with 108 sacks of 50# cement and 2% calcium chloride. Estimated 68 sacks below retainer at 1000'-TP. Reversed out estimated 40 sacks of cement. Finished 1:30 am 6/8/59. Pulled 2" tubing and shut down for cement to set.

On June 9, swabbed and bailed hole dry to top of retainer at 3660' and 5 1/2" casing tested dry. Drilled retainer and cement plug to 3690', hole dry.

PLUGGED BACK TOTAL DEPTH 3690'

Casing Perforation No. 4 - Lansing Line - 3681'-3687'
3681'-3687' 36 A-2 holes

Tested 10 gallons of muddy oil per hour. Treated through 5 1/2" casing with 500 gallons of Dowell "XF-38" acid as follows:

TREATMENT NO. 4 - Acidized 3681'-3687'

Treatment put in 6/10/59 by Dowell Inc., using 500 gallons of acid and 90 barrels of oil.

TIME	CP	IF	REMARKS
11:30 pm			Start acid
11:35 pm			Acid in, start oil
12:30 am	200%		
1:00 am	300%		
1:55 am	300%		Treatment completed

Swabbed through 5 1/2" casing 2 hours, 90 barrels of oil used in treating, then swabbed 3 hours, 29 barrels of formation oil and 1 barrel of water (part acid water). On June 10, swabbed through 5 1/2" casing 6 hours, 59 barrels of oil and 10 barrels of water (33 gravity oil at 80°).

Ran 2" tubing and rods. POB 9 hours, 91 barrels of oil and 16 barrels of water. On June 11, POB 6 hours, 53 barrels of oil and 10 barrels of water. Then POB 8 hours on State Corporation physical potential test, 61.25 barrels of oil and 5.35 barrels of water to establish 24 hour S.C.C. potential of 184 barrels. This potential allows 28 barrels per day for the remainder of June, 1959.

DEPTH	SLOPE TEST DATA	
	ANGLE OF DEFLECTION	
500'	1/2	degree
1000'	1/2	"
1250'	1/2	"
2195'	3/4	"
2850'	1/4	"
3350'	1/2	"

SKELLY OIL COMPANY

CHANGE IN WELL RECORD

Give complete description of all cleaning out, deepening, plugging back and fishing jobs, changes in casing, material lost in hole, etc, not recorded in original well record.

LEASE NAME Griffith "A"
 SEC. 11 T. 10S R. 23W
 BLOCK _____ SURVEY _____

WELL NO. 1 DISTRICT Platte
 COUNTY Graham AFE NO. 21545
 STATE Kansas

TYPE OF WORK PLUG AND ABANDON WELL

Date commenced December 3, 19 66 Date completed December 10, 19 66
 Deepened from _____ to _____ Total Depth _____
 Plugged back from 3690' to Surface P.B.T.D. _____
 Cleaned out from _____ to _____
 Production before 2 bbls. oil 11 bbls. water -- cu. ft. gas
 Production after _____ bbls. oil _____ bbls. water _____ cu. ft. gas
 Tools owned by; Southwest Casing Pulling Co. Kind used; Pulling Unit No. days rig time; _____
 Cost of Job \$ _____ Revised Estimated Payout (Mos.) _____

TREATMENT RECORD

DATE	TYPE TREATMENT	INTERVAL TREATED	AMOUNT OF TREATMENT

CHANGES IN CASING RECORD

STRINGS	SIZE	WHERE SET (Depth)	CEMENTING RECORD		REMARKS
			Socks Used	Top Cem't. Bh'd. Cas'g.	
Production					
Liner					Top liner;

SIZE	WT.	THDS.	KIND	COND.	LEFT IN				PULLED OUT						
					Jts.	LTM		WTM		Jts.	LTM		WTM		
5-1/2	14.5	8R	J55 R2 SS	C											
5-1/2	14	8R	J55 R2 SS	D	38	1150	0	1162	0	16	492	0	496	0	

PRODUCING FROM

FORMATION _____ thru OPEN HOLE PERFORATIONS _____ TOP _____ BOTTOM _____ Total No. Shots _____

REMARKS (Give review of work performed and any other comment of interest)

As the well was no longer economical to operate and as there were no further zones considered worthy of testing, regular authority was granted to plug and abandon the well.

December 3, 1966, moved in and rigged up pulling unit of Brown Bros. Well Service and pulled tubing and rods. Moved out pulling unit December 3, 1966.

December 6, 1966, moved in and rigged up pulling unit of Southwestern Casing Pulling Co., Inc. and plugged the well as follows:

Sand 3690' to 3650'
 5 sacks of cement 3650' to 3610'

Shot 5 1/2" casing at 3310', 3215', 3090', 2995', 2900' and 2815'.
 Pulled 2827' of 5 1/2" casing.

Gelled mud 3610' to 400'
 65 sacks of cement 400' to 200'
 Gelled mud 200' to 30'
 10 sacks of cement 30' to Base of cellar
 Surface soil Cellar to surface

Plugged and abandoned December 10, 1966.