


STATE OF KANSAS
STATE CORPORATION COMMISSION

Give All Information Completely
Make Required Affidavit
Mail or Deliver Report to:
Conservation Division
State Corporation Commission
800 Bitting Building
Wichita, Kansas

15-065-00732-00-00

WELL PLUGGING RECORD

NORTH

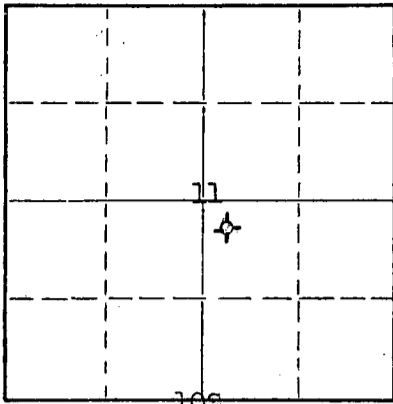

Locate well correctly on above
Section Plat

Graham County. Sec. 11 Twp. 10S Rge. 23 (E) W (W)

Location as "NE/CNW/SW" or footage from lines NW/4 NW/4 SE/4
Lease Owner Heathman-Seeligson Drilling Co.
Lease Name GRIFFITH "D" Well No. 1
Office Address 1015 East Second, Wichita, Kansas
Character of Well (completed as Oil, Gas or Dry Hole) Dry Hole
Date well completed 10-30-1955
Application for plugging filed 10-30-1955
Application for plugging approved 10-30-1955
Plugging commenced 10-30-1955
Plugging completed 10-30-1955
Reason for abandonment of well or producing formation Dry and abandoned

If a producing well is abandoned, date of last production ----- 19____
Was permission obtained from the Conservation Division or its agents before plugging was commenced? yes

Name of Conservation Agent who supervised plugging of this well Eldon Petty, Box 326, Hays, Kansas
Producing formation ----- Depth to top -- Bottom -- Total Depth of Well 4176 Feet
Show depth and thickness of all water, oil and gas formations.

OIL, GAS OR WATER RECORDS

CASING RECORD

FORMATION	CONTENT	FROM	TO	SIZE	PUT IN	PULLED OUT
				9 jts. 8-5/8" used		
				csg. set at 166.18'		
				cemented w/125 sx.		
				cement & 2 Calcium		
				Chloride.		

Describe in detail the manner in which the well was plugged, indicating where the mud fluid was placed and the method or methods used in introducing it into the hole. If cement or other plugs were used, state the character of same and depth placed, from _____ feet to _____ feet for each plug set.

Stirred pit. Filled hole with heavy mud to 160'. Set plug with 1/2 sacks hulls & 15 sacks cement. Filled hole to 10' and set top plug with 1/2 sacks hulls and 10 sacks cement.

(If additional description is necessary, use BACK of this sheet)

Name of Plugging Contractor Heathman-Seeligson Drilling Co.
Address 1015 East Second, Wichita, Kansas

STATE OF Kansas, COUNTY OF Sedgwick, ss.
H. D. Shreve (employee of owner) or owner or operator of the above-described well, being first duly sworn on oath, says: That I have knowledge of the facts, statements, and matters herein contained and the log of the above-described well as filed and that the same are true and correct. So help me God.

(Signature) [Signature]
1015 East Second, Wichita, Kansas
(Address)

SUBSCRIBED AND SWORN TO before me this 31 day of October, 1955

My commission expires June 28, 1956

[Signature] Notary Public.

11-03-1955

PLUGGING
FILE SEC. 11 T. 10R. 23W
BOOK PAGE 12 LINE 7

15-065-00732-00-00

DRILLERS' LOG

NAME: GRIFFITH "D" #1 DATE SPUDDED: 10-20-55
 LOCATION: NW/4 NW/4 SE/4 Sec.11-10S-23W ROTARY COMPLETED: 10-30-55
 Graham County, Kansas
 OPERATOR: Heathman-Seeligson Drilling Co. ELEVATION: 2398 DF
 2396 GR
 2401 KB
 CONTRACTOR: Heathman-Seeligson Drilling Co. ROTARY TOTAL DEPTH: 4176'
 SURFACE CASING: 9 jts. 8-5/8" used casing
 cemented at 166.18' with 125
 sacks of sack cement and 2
 Calcium Chloride. Cement:
 Circulated.
 OIL STRING: None run - Dry and abandoned 10-30-55

DRILL STEM TESTS

DST #1, 3885-3902, open 1 hr.
 rec. 8' mud, BHP-0#.
 DST #2, 3904-3920, open 1 hr.
 rec. 15' mud, BHP-0#.

GEOLOGICAL TOPS (KB)

Anhydrite	1960 (441)
Topeka	3465 (-1064)
Heekner	3692 (-1291)
Toronto	3715 (-1314)
Lansing K.C.	3728 (-1327)
Base K.C.	3956 (-1555)
Marmaton	3998 (-1597)
Marmaton Chert	4048 (-1647)
Marmaton Sandy Conglomerate	4137 (-1736)
R.T.D.	4176'

LOG

(Figures indicate bottom of formation)

Soil Clay, Sand & Shale	0 - 168
Shale, Shells & Sand	1205
Sand	1280
Shale, Shells & Sand	1490
Sand	1705
Shale & Red Bed	1960
Anhydrite	2015
Shale & Shells	2445
Lime & Shale	3697
Lime	3965
Lime & Shale	4040
Lime, Shale & Chert	4086
Shale & Lime	4135
Shale, Lime & Chert	4176

The undersigned, H. D. Shreve, hereby certifies that the above log is a true and correct log of the formations encountered in drilling the above noted well as reflected by the Daily Drilling Reports.

HEATHMAN-SEELIGSON DRILLING CO.

By: *H. D. Shreve*

Subscribed and sworn to before me this 31st day of October, 1955

D. Marjorie Matt
Notary Public

My commission expires: June 28, 1956

PLUGGING
 FILE SEC 11 T 10 R 23W
 BOOK PAGE 12 LINE 7

RECEIVED
 OCT 31 1955
 11-03-1955