


Give All Information Completely  
Make Required Affidavit  
Mail or Deliver Report to:  
Conservation Division  
State Corporation Commission  
800 Bitting Building  
Wichita, Kansas

NORTH

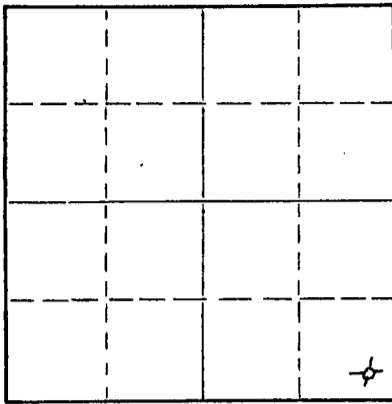

Locate well correctly on above  
Section Plat

Graham County. Sec. 25 Twp. 10S Rge. 23 (E) W (W)  
Location as "NE/CNWxSWx" or footage from lines SE SE SE  
Lease Owner Colorado Oil and Gas Corporation  
Lease Name Griffith Well No. 2  
Office Address P.O. Box 749, Denver 1, Colorado  
Character of Well (completed as Oil, Gas or Dry Hole) Dry Hole  
Date well completed Aug. 14 1955  
Application for plugging filed Aug. 14 1955  
Application for plugging approved Aug. 14 1955  
Plugging commenced Aug. 14 1955  
Plugging completed Aug. 15 1955  
Reason for abandonment of well or producing formation Dry Hole

If a producing well is abandoned, date of last production \_\_\_\_\_ 19\_\_\_\_  
Was permission obtained from the Conservation Division or its agents before plugging was commenced? Yes

Name of Conservation Agent who supervised plugging of this well Eldon Petty  
Producing formation \_\_\_\_\_ Depth to top \_\_\_\_\_ Bottom \_\_\_\_\_ Total Depth of Well 3808 Feet  
Show depth and thickness of all water, oil and gas formations.

OIL, GAS OR WATER RECORDS

CASING RECORD

FORMATION	CONTENT	FROM	TO	SIZE	PUT IN	PULLED OUT
		0	193'	8 5/8"	193'	None

Describe in detail the manner in which the well was plugged, indicating where the mud fluid was placed and the method or methods used in introducing it into the hole. If cement or other plugs were used, state the character of same and depth placed, from \_\_\_\_\_ feet to \_\_\_\_\_ feet for each plug set.

From 3808' to 191 1/2' - heavy rotary mud  
191 1/2' to 190' - wooden plug  
190' to 144' - 15 sacks cement and 1/2 sack hulls  
144' to 41 1/2' - heavy rotary mud  
41 1/2' to 40' - wooden plug  
40' to 6' - 10 sacks cement and 1/2 sack hulls  
6' to surface - cellar

(If additional description is necessary, use BACK of this sheet)  
Name of Plugging Contractor Glenn W. Peel  
Address P.O. Box 359, Hoisington, Kansas

STATE OF KANSAS, COUNTY OF BARTON, ss.  
Glenn W. Peel (employee of owner) or ~~(owner or operator)~~ of the above-described well, being first duly sworn on oath, says: That I have knowledge of the facts, statements, and matters herein contained and the log of the above-described well as filed and that the same are true and correct. So help me God. GLENN W. PEEL

(Signature) \_\_\_\_\_ BY: Glenn W. Peel  
P.O. Box 359, Hoisington, Kansas  
(Address)

SUBSCRIBED AND SWORN TO before me this 15<sup>th</sup> day of August, 1955

Maria M. Habet  
Notary Public.

My commission expires June 4, 1959

**PLUGGING**  
FILE SEC 25 T10 R 23W  
BOOK PAGE 44 LINE 7

RECEIVED  
STATE CORPORATION COMMISSION  
AUG 23 1955  
CONSERVATION DIVISION  
Wichita, Kansas

15-065-02305-00-00

DRILLERS' LOG

Company: Colorado Oil & Gas Corporation

SE SE SE

Farm Name: Griffith

Well No. 2

Sec. 25, Twp. 10S, Rge. 23W,

Total Depth: 3808'

County: Graham,  
Kansas

Comm: 8-5-55

Comp: 8-15-55

Contractor: Glenn W. Peel

Elevation:

Casing: 8 5/8" 193' cem.

Production: Dry

Figures below indicate bottoms of formations:

Surface soils	0	40
Sand		90
Shale		405
Shale and shells		815
Shale, shells and sand		1450
Shale and shells		1803
Anhydrite		1844
Shale and shells		2190
Shale and lime		2650
Lime		2720
Lime and shale		3000
Lime and shale streaks		3100
Lime and shale		3335
Lime		3808
Total Depth		3808

This is to certify that the above information is to the best of our knowledge, true and correct.

GLENN W. PEEL

BY: Glenn W. Peel

SUBSCRIBED AND SWORN to before me this 15<sup>th</sup> day of August, 1955.

My commission expires: June 4, 1959

Marion M. Herbert  
Notary Public

RECEIVED

08-23-1955

**PLUGGING**  
FILE SEC 25 T10 R23W  
BOOK PAGE 144 LINE 2