


WELL PLUGGING RECORD

Give All Information Completely  
Make Required Affidavit  
Mail or Deliver Report to:  
Conservation Division  
State Corporation Commission  
211 No. Broadway  
Wichita, Kansas

NORTH

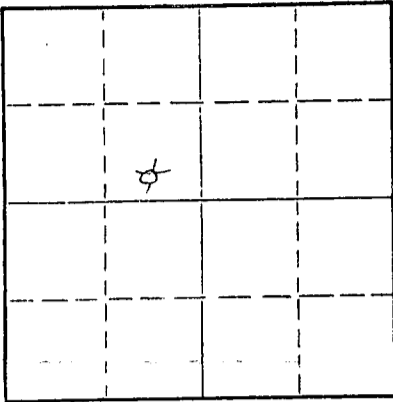

Locate well correctly on above  
Section Plat

Trego County, Sec. 35 Twp. 11, Rge. (E) 21 (W)  
Location as "NE/CNWxSWx" or footage from lines C S/2 SE NW  
Lease Owner Robinowitz Oil Co.  
Lease Name Cockrell Well No. 1  
Office Address 1322 East 50th St., Tulsa, Oklahoma  
Character of Well (completed as Oil, Gas or Dry Hole) Dry hole  
Date well completed 2/9 1965  
Application for plugging filed 2/9 1965  
Application for plugging approved 2/9 1965  
Plugging commenced 2/9 1965  
Plugging completed 2/9 1965  
Reason for abandonment of well or producing formation Dry

If a producing well is abandoned, date of last production 19  
Was permission obtained from the Conservation Division or its agents before plugging was commenced? yes

Name of Conservation Agent who supervised plugging of this well Mr. Nichols  
Producing formation Dry Depth to top Bottom Total Depth of Well 3913 Feet  
Show depth and thickness of all water, oil and gas formations.

OIL, GAS OR WATER RECORDS

CASING RECORD

FORMATION	CONTENT	FROM	TO	SIZE	PUT IN	PULLED OUT
Pennsylvanian	Water & Barren	2480	T. D.	8 5/8	215	none

Describe in detail the manner in which the well was plugged, indicating where the mud fluid was placed and the method or methods used in introducing it into the hole. If cement or other plugs were used, state the character of same and depth placed, from 540 feet to zero feet for each plug set.

Mud to 540'  
20 sax cement at 540'  
Mud to 210'  
20 sax cement at 210'  
Mud to 40'  
10 sax cement & hulls at 40'

RECEIVED  
STATE CORPORATION COMMISSION  
2-19-1965  
FEB 19 1965

CONSERVATION DIVISION  
Wichita, Kansas

(If additional description is necessary, use BACK of this sheet)

Name of Plugging Contractor Rotary  
Address

STATE OF Florida, COUNTY OF Dade, ss.  
Joseph Teichman (employee of owner) or (owner or operator) of the above-described

well, being first duly sworn on oath, says: That I have knowledge of the facts, statements, and matters herein contained and the log of the above-described well as filed and that the same are true and correct. So help me God.

(Signature) Joseph Teichman  
6045 Pine Tree Drive, Miami Beach, Fla.  
(Address)

SUBSCRIBED AND SWORN TO before me this 15th day of February, 1965

NOTARY PUBLIC STATE OF FLORIDA at LARGE  
MY COMMISSION EXPIRES JUNE 9, 1968  
BONDED THROUGH FRED W. DIESTELHORST

Miriam Unger  
Notary Public.

My commission expires

15-195-30037-00-00

SHOLOM DRILLING COMPANY, INCORPORATED

6045 Pine Tree Drive  
Miami Beach, Florida 33140

COMPANY: Robinowitz Oil Company  
FARM: Cockrell  
LOCATION: #1 C 3/2. <sup>NE</sup> NW Sec 35 T11S R21W, Trego County, Kansas  
ROTARY DRILLING CONTRACTOR: Sholom Drilling Co., Inc.

COMMENCED: 2/2/65  
COMPLETED: 2/9/65  
I. P. : D & A

Elevation: 2292 K. B.  
Rotary T. D.: 3913'

Logging Record:  
B 5/8" @ 215' W/150 sax

L O G

- 0 - 50 Clay
- 50 - 130 Post Rock
- 130 - 215 Shale
- 215 - 765 Shale & Sand
- 765 - 1210 Sand & Shale
- 1210 - 1460 Sand
- 1460 - 1570 Red Bed & Shale
- 1570 - 1718 Shale & Shells
- 1718 - 1765 Anhydrite
- 1765 - 1880 Shale & Shells
- 1880 - 2010 Shale & Lime
- 2010 - 2180 Lime & Shale
- 2180 - 2775 Lime
- 2775 - 3275 Lime & Shale
- 3275 - 3580 Lime
- 3580 - 3913 Lime
- 3913 T. D.

RECEIVED  
STATE CORPORATION COMMISSION  
2-19-1965  
FEB 19 1965

CONSERVATION DIVISION  
Wichita, Kansas

STATE OF FLORIDA )  
                          ) ss.  
COUNTY OF DADE )

I, Dorothy Teichman, Secretary of Sholom Drilling Company, Inc., a corporation of the State of Oklahoma, domesticated in the State of Kansas, being first duly sworn under oath, says: That I have knowledge of the facts, statements and matters herein contained of the above described well as filed and that the same are true and correct.

Dorothy Teichman  
Dorothy (Mrs. Joseph) Teichman

Subscribed and sworn to before me this 15th day of February, 1965.

NOTARY PUBLIC STATE OF FLORIDA at LARGE  
MY COMMISSION EXPIRES JUNE 9, 1968  
BONDED THROUGH FRED W. DIESTELHORST

Miriam Unger  
Notary Public Miriam Unger