


WELL PLUGGING RECORD

Give All Information Completely  
Make Required Affidavit  
Mail or Deliver Report to:  
Conservation Division  
State Corporation Commission  
800 Bitting Building  
Wichita, Kansas

Russell County, Sec. 27 Twp. 11 Rge. 15 (E) W (W)

Location as "NE/CNW/SW" or footage from lines SE SE SE  
Lease Owner PAM-KAR Drilling Company, Inc.  
Lease Name Eulert # 1 Well No. 1  
Office Address 333 1st National Bank, Wichita, Kansas  
Character of Well (completed as Oil, Gas or Dry Hole) Dry Hole  
Date well completed March 6 1954  
Application for plugging filed March 6 1954  
Application for plugging approved March 6 1954  
Plugging commenced March 6 1954  
Plugging completed March 6 1954  
Reason for abandonment of well or producing formation D & A

NORTH

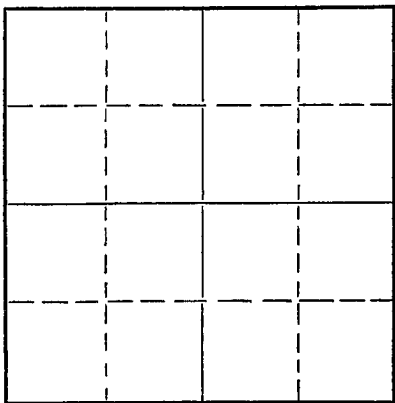

Locate well correctly on above Section Plat

If a producing well is abandoned, date of last production 19  
Was permission obtained from the Conservation Division or its agents before plugging was commenced? Yes

Name of Conservation Agent who supervised plugging of this well Eldon Petty  
Producing formation \_\_\_\_\_ Depth to top \_\_\_\_\_ Bottom \_\_\_\_\_ Total Depth of Well 3301 Feet  
Show depth and thickness of all water, oil and gas formations.

OIL, GAS OR WATER RECORDS

CASING RECORD

FORMATION	CONTENT	FROM	TO	SIZE	PUT IN	PULLED OUT
				8 5/8"	195'	none

Describe in detail the manner in which the well was plugged, indicating where the mud fluid was placed and the method or methods used in introducing it into the hole. If cement or other plugs were used, state the character of same and depth placed, from \_\_\_\_\_ feet to \_\_\_\_\_ feet for each plug set.

Mudded hole to 190'. Set Plug. Cemented through drill pipe with 15 sacks of cement and 1/2 sack of hulls. Filled with heavy mud to 40'. Set plug. 1/2 sack of hulls and 10 sacks cement. Filled plug to top. All plugs secured with 2 strands of .066 HOW60 steel line

3-22-1954

(If additional description is necessary, use BACK of this sheet)  
Name of Plugging Contractor Pam-Kar Drilling Co., Inc.  
Address 333 First National Bank Bldg. Wichita, Kansas

STATE OF KANSAS, COUNTY OF SEDGWICK, ss.  
Ralph B. McLaughlin (employee of owner) or (owner or operator) of the above-described well, being first duly sworn on oath, says: That I have knowledge of the facts, statements, and matters herein contained and the log of the above-described well as filed and that the same are true and correct. So help me God.

(Signature) Ralph B. McLaughlin  
333 First Nat'l Bank, Wichita, Kansas  
(Address)

SUBSCRIBED AND SWORN TO before me this 9th day of March, 1954

My commission expires Sept. 4, 1957

[Signature]  
Notary Public.

**PLUGGING**  
FILE SEC 22 T 11 R 15 W  
BOOK PAGE 18 LINE 14

15-167-0073-00-00

PAM-KAR DRILLING COMPANY  
WICHITA, KANSAS

Well: Eulert  
Commenced RD 2-25-54  
Completed RD 3-6-54

SE SE SE  
Sec. 27-11S-15W  
Russell County, Kansas

Total Depth: 3301'

Elevation: 1785 KB

Csg: 195' 8 5/8" O.D. 2 1/2" 8 rnd

Contractor: Pam-Kar  
Drilg. Company, Inc.

STRATA	DEPTH	TOPS
Shale, rock & pyrite	100	Heebner - 2885-1100
Shale, shells & pyrite	165	Toronto - 2906-1121
Shale & shells	255	Lansing - 2935-1150
Redbed & Gumbo	270	Cong. - 3256-1471
Gumbo, Shale	405	Arbuckle - 3297-1512
Gumbo with Flint & pyrite	530	
Redbeds	675	
Redbed & sand	855	
Anhydrite	915	
Shale & shells	1270	D & A
Shale & salt	1388	
Shale & shells	1500	
Broken Lime	2060	
Lime & shale	2150	
Shale & lime	2715	
Lime & shale	3246	
Lime, chirt & shale	3297 1/2	
Total Depth	3301	

I hereby certify that the above is a true and correct log of said well as reflected by the daily drilling reports.

PAM-KAR DRILLING COMPANY, INC.  
BY

*Ralph B. McLaughlin*  
Ralph B. McLaughlin

Signed and sworn to in my presence this 9th day of March, 1954, by Ralph B. McLaughlin, Secretary of the Pam-Kar Drilling Company, Inc., a corporation in the State of Kansas.

*[Signature]*  
Notary Public

My commission expires Sept. 4, 1957.

**PLUGGING**  
FILE SEC 27-11S-15W  
BOOK PAGE 18 LINE 14

RECEIVED  
COMMISSION  
KANSAS