

15-167-01022-00-00

STATE OF KANSAS
STATE CORPORATION COMMISSION

Form CP-4


Give All Information Completely
Make Required Affidavit
Mail or Deliver Report to:
Conservation Division
State Corporation Commission
211 No. Broadway
Wichita, Kansas

WELL PLUGGING RECORD

Russell County, Sec. 27 Twp. 11S Rge. (E) 15 (W)

Location as "NE/CNW/SW" or footage from lines SE SW SW
Lease Owner Abercrombie Drilling, Inc.
Lease Name HAGAMAN Well No. 1
Office Address 801 Union Center, Wichita, Kansas, 67202
Character of Well (completed as Oil, Gas or Dry Hole) Dry hole
Date well completed August 17, 19 64
Application for plugging filed verbally August 17, 19 64
Application for plugging approved verbally August 17, 19 64
Plugging commenced August 17, 19 64
Plugging completed midnight August 17, 19 64
Reason for abandonment of well or producing formation Dry

NORTH

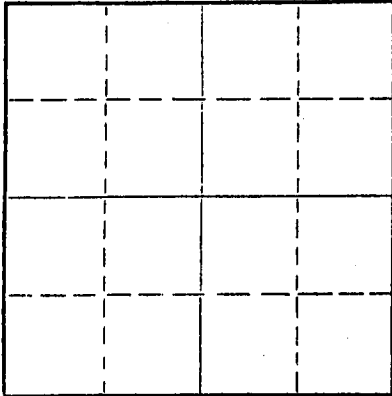

Locate well correctly on above
Section Plat

If a producing well is abandoned, date of last production 19
Was permission obtained from the Conservation Division or its agents before plugging was commenced? verbally - yes.

Name of Conservation Agent who supervised plugging of this well Donald Truan, 634 Sunset, Russell, Kansas
Producing formation _____ Depth to top _____ Bottom _____ Total Depth of Well 3317 Feet
Show depth and thickness of all water, oil and gas formations.

OIL, GAS OR WATER RECORDS

CASING RECORD

| FORMATION | CONTENT | FROM | TO | SIZE | PUT IN | PULLED OUT |
|-----------|---------|------|----|--------|--------|------------|
| | | | | 8-5/8" | 241' | None |
| | | | | | | |
| | | | | | | |
| | | | | | | |
| | | | | | | |
| | | | | | | |
| | | | | | | |
| | | | | | | |
| | | | | | | |

Describe in detail the manner in which the well was plugged, indicating where the mud fluid was placed and the method or methods used in introducing it into the hole. If cement or other plugs were used, state the character of same and depth placed, from _____ feet to _____ feet for each plug set.

Filled hole with heavy mud to 240'
Set 1st Plug at 240' w/ 25 sx cement & 1/4 sk hulls
Filled hole w/heavy mud to 40'
Set 2nd lug at 40' w/10 sx cement.

RECEIVED
STATE CORPORATION COMMISSION
8-21-1964
AUG 21 1964

CONSERVATION DIVISION
Wichita, Kansas

(If additional description is necessary, use BACK of this sheet)
Name of Plugging Contractor Abercrombie Drilling, Inc.
Address 801 Union Center, Wichita, Kansas 67202

STATE OF Kansas, COUNTY OF Sedgwick, ss.
Mildred Saxton (employee of owner) or (owner or operator) of the above-described well, being first duly sworn on oath, says: That I have knowledge of the facts, statements, and matters herein contained and the log of the above-described well as filed and that the same are true and correct. So help me God.

(Signature) Mildred Saxton
801 Union Center, Wichita, Kansas 67202
(Address)

SUBSCRIBED AND SWORN TO before me this 20 day of August, 1964

My commission expires June 16, 1967

Leah Faye Hefke
Leah Faye Hefke Notary Public.

CONTRACTOR'S WELL LOG

COMPANY: Abercrombie Drilling, Inc.
 CONTRACTOR: Abercrombie Drilling, Inc.
 FARM: HAGAMAN #1
 LOCATION: SE SW SW
 Sec. 27-11S-15W
 Russell County, Kansas
 COMMENCED: August 6, 1964
 COMPLETED: August 17, 1964

| | | |
|------|------|--------------------------|
| 0 | 65 | Surface Clay & Post Rock |
| 65 | 235 | Shale & Shells |
| 235 | 250 | Shale |
| 250 | 650 | Shale & Shells |
| 650 | 873 | Red Bed |
| 873 | 914 | Anhydrite |
| 914 | 1197 | Shale & Shells |
| 1197 | 1548 | Shale |
| 1548 | 2846 | Shale & Lime |
| 2846 | 2966 | Lime |
| 2966 | 3010 | Lime & Shale |
| 3010 | 3317 | Lime |
| | 3317 | Rotary Total Depth |

Set 8-5/8" Surface Casing at 241' with 140 sx cement

DRY & ABANDONED

ELEVATION: 1807' K. B.

ELECTRIC LOG TOPS:
 Anhydrite 873 - 914
 Topeka 2636' (- 829)
 Heebner 2908' (-1101)
 Toronto 2927' (-1120)
 Lansing 2959' (-1152)
 Erosional Arbuckle 3272' (-1465)
 Arbuckle 3291' (-1484)
 Elec. Log T. D. 3318' (-1511)

RECEIVED
 STATE CORPORATION COMMISSION
 8-21-1964
 AUG 21 1964

CONSERVATION DIVISION
 Wichita, Kansas

STATE OF KANSAS)
) SS
 COUNTY OF SEDGWICK)

I, Mildred Saxton, do hereby certify that the above and foregoing is a true and correct copy of the log of the HAGAMAN #1, SE SW SW, Sec. 27-11S-15W, Russell County, Kansas, as reflected by the files of Abercrombie Drilling, Inc.

Mildred Saxton
 Mildred Saxton

Subscribed and sworn to before me, a Notary Public, in and for Sedgwick County, Kansas, this 20th day of August, 1964.

Leah Faye Heferle
 Leah Faye Heferle, Notary Public

My commission expires June 16, 1967.