


STATE OF KANSAS
STATE CORPORATION COMMISSION
Give All Information Completely
Make Required Affidavit
Mail or Deliver Report to:
Conservation Division
State Corporation Commission
800 Bitting Building
Wichita, Kansas

NORTH

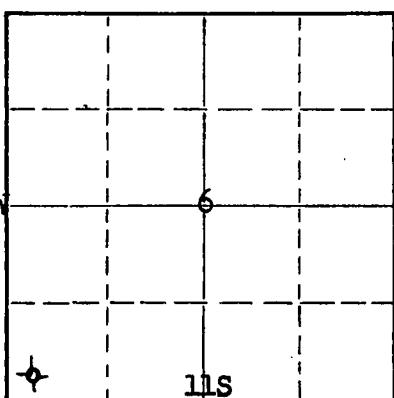

Locate well correctly on above
Section Plat

Name of Conservation Agent who supervised plugging of this well Eldon Petty at Hays, Kansas

Producing formation _____ Depth to top _____ Bottom _____ Total Depth of Well 4395 Feet
Show depth and thickness of all water, oil and gas formations.

OIL, GAS OR WATER RECORDS

CASING RECORD

FORMATION	CONTENT	FROM	TO	SIZE	PUT IN	PULLED OUT
<u>None</u>	<u>None</u>	<u>0</u>	<u>196'</u>	<u>8 5/8"</u>	<u>196'</u>	<u>None</u>
cemented with 100 sacks cement and 1 Gal. Chloride						
(No oil string run - dry and abandoned)						

Describe in detail the manner in which the well was plugged, indicating where the mud fluid was placed and the method or methods used in introducing it into the hole. If cement or other plugs were used, state the character of same and depth placed, from _____ feet to _____ feet for each plug set.

Set bottom plug with heavy mud at 185' with 19 sacks cement.

Set top plug with heavy mud at 40' with 10 sacks cement.

RECEIVED
STATE CORP. COMMISSION
5-6-1954

CONCERNED

(If additional description is necessary, use BACK of this sheet)

Name of Plugging Contractor Walters Drilling Co., Inc.
Address 510 Orpheum Building, Wichita, Kansas

STATE OF KANSAS, COUNTY OF SEDGWICK, ss.
C. Allan Gilmour (employee of owner) or ~~OWNER OR OPERATOR~~ of the above-described well, being first duly sworn on oath, says: That I have knowledge of the facts, statements, and matters herein contained and the log of the above-described well as filed and that the same are true and correct. So help me God.

(Signature) C. Allan Gilmour


510 Orpheum Building, Wichita, Kansas

(Address)

SUBSCRIBED AND SWORN TO before me this 5th day of May, 19 54

My commission expires March 10, 1956

Notary Public.

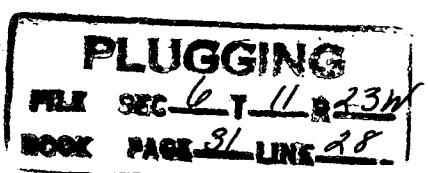

15-195-00255-00-00

WALKER NO. 1

Location: SW/4 SW/4 SW/4 Sec. 6-11S-23W Dated Spudded: 4-16-54
Trego County, Kansas

Operator: Walters Drilling Co., Inc. Rotary Completion: 4-30-54

Contractor: Walters Drilling Co., Inc. Elevation: 2291 Gr
2294 DF
2296 KB

Surface Casing: 8 5/8" set at 196' with 100 sacks cement and 1 Gal. Chloride

Oil String: None. D & A

L O G

(Figures indicate bottom of formation)

Surface	0 to 196
Shale, Shells and Sand	625
Shale and Shells	874
Sand and Shale	960
Shale and Shells	1023
Shale and Sand	1380
Sand	1592
Shale and Shells	1726
Shale and Red Bed	1885
Anhydrite	1933
Shale and Shells	2438
Shale and Lime Shells	2528
Lime	2560
Lime and Shale	3271
Shale and Shells	3325
Lime	3625
Lime and Shale	4136
Shale	4176
Lime and Shale	4238
Lime	4279
Lime, Shale and Chert	4344
Lime and Shale	4395
Total Depth	4395

The undersigned, C. Allan Gilmour, hereby certifies that the above log is a true and correct log of the formations encountered in the drilling of the above noted well as reflected by the Daily Drilling Reports.

WALTERS DRILLING CO., INC.

By C. Allan Gilmour
Vice-President

Subscribed and sworn to before me this 5 day of May, 1954.

RECEIVED
5-6-1954

Pauline Beaudoin
Notary Public

My commission expires:

March 10, 1956

PLUGGING

FILE SEC 6 T 11 R 23W
BOOK PAGE 31 LINE 28