


Give All Information Completely  
Make Required Affidavit  
Mail or Deliver Report to:  
Conservation Division  
State Corporation Commission  
211 No. Broadway  
Wichita, Kansas

WELL PLUGGING RECORD

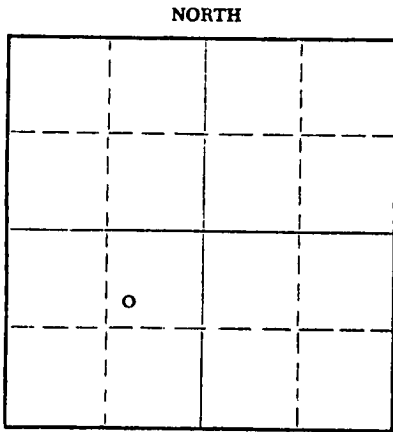

Locate well correctly on above  
Section Plat

Trego County, Sec. 7 Twp. 11S Rge. 23W (E) (W)

Location as "NE/CNW/SW" or footage from lines SW NE SW

Lease Owner Halliburton Oil Producing Co.

Lease Name Walker Well No. 1

Office Address 2915 Classen Blvd., Oklahoma City, Okla. 73106

Character of Well (completed as Oil, Gas or Dry Hole) Dry Hole

Date well completed July 28 19 70

Application for plugging filed July 28 19 70

Application for plugging approved July 28 19 70

Plugging commenced July 28 19 70

Plugging completed July 28 19 70

Reason for abandonment of well or producing formation Dry Hole

If a producing well is abandoned, date of last production 19

Was permission obtained from the Conservation Division or its agents before plugging was commenced? Yes

Name of Conservation Agent who supervised plugging of this well W. L. Nichols, Morland, Kansas

Producing formation Depth to top Bottom Total Depth of Well 3870 Feet

Show depth and thickness of all water, oil and gas formations.

OIL, GAS OR WATER RECORDS

CASING RECORD

FORMATION	CONTENT	FROM	TO	SIZE	PUT IN	PULLED OUT
		0	209'	8 5/8"	209'	None

Describe in detail the manner in which the well was plugged, indicating where the mud fluid was placed and the method or methods used in introducing it into the hole. If cement or other plugs were used, state the character of same and depth placed, from feet to feet for each plug set.

Plug: 925'/100 sacks cement  
215'/25 sacks cement  
40'/10 sacks cement

RECEIVED  
STATE CORPORATION COMMISSION  
8-3-1970  
AUG 3 1970  
CONSERVATION DIVISION  
Wichita, Kansas

Name of Plugging Contractor Hellar Drilling Company, Inc.  
Address 339 Union Center Bldg., Wichita, Kansas 67202

(If additional description is necessary, use BACK of this sheet)

STATE OF Kansas, COUNTY OF Sedgwick, ss.


D. L. Hellar, President of Hellar Drlg. Co. Inc. (employee of owner) or (owner or operator) of the above-described well, being first duly sworn on oath, says: That I have knowledge of the facts, statements, and matters herein contained and the log of the above-described well as filed and that the same are true and correct. So help me God.

(Signature) D. L. Hellar, President  
339 Union Center Bldg., Wichita, Kansas 67202  
(Address)

Subscribed and sworn to before me this 31st day of July, 19 70

My commission expires March 25, 1972.

Catherine Darcey - Notary Public.

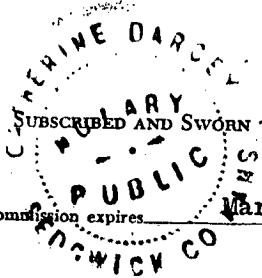

DRILLER'S LOG

COMPANY: Halliburton Oil Producing Co., 2915 Classen Blvd.  
 Oklahoma City, Okla. 73106

CONTRACTOR: Hellar Drilling Company, Inc., Wichita, Kansas 67202

LEASE: #1 Walker

LOCATION: SW NE SW 7-11S-23W, Trego County, Kansas

COMMENCED: July 20, 1970

COMPLETED: July 28, 1970

CASING: Set 8 5/8" Surface Casing @ 209'/175 sacks cement

0-34	Sand
34-47	Post Rock
47-209	Shale - Sand
209-455	Chalk - shale
455-595	Shale
595-1849	Shale & Sand
1849-1850	Shale
1850-1892	Anhydrite
1892-2170	Red Bed & Shale & Shells
2170-2395	Shale & Shells
2395-3385	Lime & shale
3385-3485	Lime
3485-3573	Lime & Chert
3573-3640	Lime
3640-3670	Lime (L.K.C.)
3670-3870	Lime
3870	Rotary Total Depth

RECEIVED  
 STATE CORPORATION COMMISSION  
 AUG 3 1970  
 CONSERVATION DIVISION  
 Wichita, Kansas

D & A

STATE OF KANSAS )  
 ) SS  
 COUNTY OF SEDGWICK )

I, D. L. Hellar, do hereby certify that the above and foregoing is a true and correct copy of the log of the #1 Walker, located in SW NE SW 7-11S-23W, Trego County, Kansas, as reflected by the files of the Hellar Drilling Company, Inc.

HELLAR DRILLING COMPANY, INC.

By *D. L. Hellar*  
 President - D. L. Hellar

Subscribed and sworn to before me, a Notary Public, in and for Sedgwick County, Kansas, this 31st day of July, 1970.

My Commission Expires  
 March 25, 1972.

*Catherine Darcey*  
 Notary Public - Catherine Darcey