


WELL PLUGGING RECORD

Give All Information Completely
Make Required Affidavit
Mail or Deliver Report to:
Conservation Division
State Corporation Commission
212 No. Market
Wichita, Kansas

Trego County. Sec. 8 Twp. 11 Rge. (E) 23 (W)
Location as "NE/CNW%SW%" or footage from lines SE SW SW
Lease Owner Halliburton Oil Producing Company
Lease Name Staggers Well No. 1
Office Address 117 Cameron Bldg., Oklahoma City, Oklahoma 73106
Character of Well (completed as Oil, Gas or Dry Hole) Dry Hole
Date well completed 6-1 19 71
Application for plugging filed 6-1 19 71
Application for plugging approved 6-1 19 71
Plugging commenced 6-1 19 71
Plugging completed 6-1 19 71
Reason for abandonment of well or producing formation _____

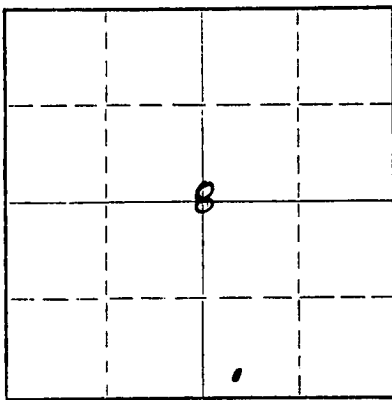

Locate well correctly on above Section Plat

If a producing well is abandoned, date of last production _____ 19 _____
Was permission obtained from the Conservation Division or its agents before plugging was commenced? Yes

Name of Conservation Agent who supervised plugging of this well Mr. W. L. Nichols
Producing formation None Depth to top _____ Bottom _____ Total Depth of Well 3900 Feet
Show depth and thickness of all water, oil and gas formations.

OIL, GAS OR WATER RECORDS

CASING RECORD

FORMATION	CONTENT	FROM	TO	SIZE	PUT IN	PULLED OUT
None				8 5/8"	208	None

Describe in detail the manner in which the well was plugged, indicating where the mud fluid was placed and the method or methods used in introducing it into the hole. If cement or other plugs were used, state the character of same and depth placed, from _____ feet to _____ feet for each plug set.

Plugs: 875 to 425' with 100 sacks cement
215 to 136' with 20 sacks cement
40 to surface with 10 sacks cement

RECEIVED
STATE CORPORATION COMMISSION
6-30-1971
JUN 30 1971
CONSERVATION DIVISION
Wichita, Kansas

(If additional description is necessary, use BACK of this sheet)

Name of Plugging Contractor Gabbert-Jones, Inc.
Address 830 Sutton Place, Wichita, Kansas

STATE OF Oklahoma, COUNTY OF Oklahoma, ss.
D. D. Swearingen (employee of owner) or (owner or operator) of the above-described well, being first duly sworn on oath, says: That I have knowledge of the facts, statements, and matters herein contained and the log of the above-described well as filed and that the same are true and correct. So help me God.

(Signature) D. D. Swearingen
117 Cameron Bldg., Oklahoma City, Oklahoma 73106
(Address)

SUBSCRIBED AND SWORN TO before me this 29th day of June, 19 71

Reuben A. Osfield
Notary Public.

My commission expires 1-17-73

