


WELL PLUGGING RECORD

Give All Information Completely
Make Required Affidavit
Mail or Deliver Report to:
Conservation Division
State Corporation Commission
212 No. Market
Wichita, Kansas

Trego County, Sec. 10 Twp. 11 Rge. 23 (E) W (W)
Location as "NE/CNW%SW%" or footage from lines SE, SW, SW
Lease Owner John P. Jennings
Lease Name Galloway Well No. 1
Office Address 412 Union Center, Wichita, Kansas 67202
Character of Well (completed as Oil, Gas or Dry Hole) Oil Well
Date well completed September 24 19 66
Application for plugging filed April 10 19 67
Application for plugging approved April 19 19 67
Plugging commenced June 13 19 67
Plugging completed June 15 19 67
Reason for abandonment of well or producing formation Uneconomic Production
If a producing well is abandoned, date of last production March 31 19 67
Was permission obtained from the Conservation Division or its agents before plugging was commenced? yes

NORTH

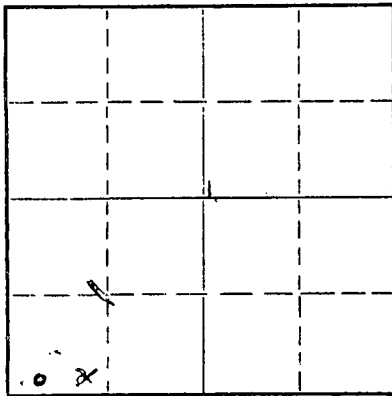

Locate well correctly on above Section Plat

Name of Conservation Agent who supervised plugging of this well W. L. Nichols
Producing formation Kansas City Depth to top 3700 Bottom 3710 Total Depth of Well 3710 Feet
Show depth and thickness of all water, oil and gas formations.

OIL, GAS OR WATER RECORDS

CASING RECORD

FORMATION	CONTENT	FROM	TO	SIZE	PUT IN	PULLED OUT
<u>Kansas City</u>	<u>Production Casing</u>	<u>0</u>	<u>3710</u>	<u>4 1/2</u>	<u>3710</u>	<u>2728</u>

Describe in detail the manner in which the well was plugged, indicating where the mud fluid was placed and the method or methods used in introducing it into the hole. If cement or other plugs were used, state the character of same and depth placed, from _____ feet to _____ feet for each plug set.

Filled with sand from 3710'
Ran 3 sacks of cement from 3700' to 3670'
Shot at 2807' & 2767'
Shot at 2685'
Pumped 20 sacks of mud, 3 sacks of hulls & 50 sacks of cement to plug 7" pipe.

RECEIVED
STATE CORPORATION COMMISSION
7-26-1967
AUG 26 1967
CONSERVATION DIVISION
WICHITA, KANSAS

(If additional description is necessary, use BACK of this sheet)

Name of Plugging Contractor Glenn & Smith Pipe Pulling Company
Address Box 156, Ellinwood, Kansas

STATE OF KANSAS, COUNTY OF SEDGWICK, ss.
John P. Jennings (employee of owner) or (owner or operator) of the above-described

well, being first duly sworn on oath, says: That I have knowledge of the facts, statements, and matters herein contained and the log of the above-described well as filed and that the same are true and correct. So help me God.

(Signature) [Signature]
John P. Jennings, Operator
412 Union Center, Wichita, Kansas 67202

SUBSCRIBED AND SWORN TO before me this 25th day of July, 19 67

Carolyn S. Baltz
Carolyn S. Baltz Notary Public.

My commission expires August 18, 1970

