

15-195-20345-00-00

STATE OF KANSAS
STATE CORPORATION COMMISSION


Form CP-4

Give All Information Completely
Make Required Affidavit
Mail or Deliver Report to:
Conservation Division
State Corporation Commission

WELL PLUGGING RECORD

P. O. Box 17027
Wichita, Kansas 67217
NORTH

Trego County, Sec. 10, Twp. 11S, Rge. 23 (W)
Location as "NE/CNW&SW" or footage from lipes C W/2 SW/4
Lease Owner John P. Jennings
Lease Name GALLOWAY Well No. #1
Office Address Suite 309, 200 E. 1st Street, Wichita, Ks. 67202
Character of Well (completed as Oil, Gas or Dry Hole) Dry Hole
Date well completed November 20, 1975
Application for plugging filed (verbally) November 20, 1975
Application for plugging approved (verbally) November 20, 1975
Plugging commenced November 20, 1975
Plugging completed November 20, 1975
Reason for abandonment of well or producing formation No commercial quantity
of oil or gas encountered.
If a producing well is abandoned, date of last production 19__
Was permission obtained from the Conservation Division or its agents before plugging was commenced? Yes

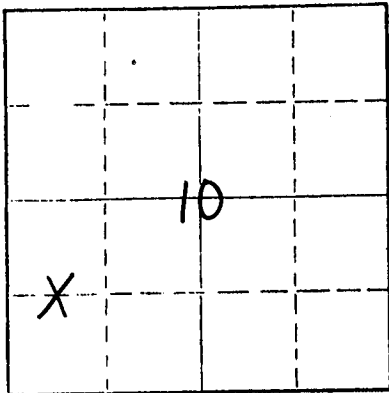

Locate well correctly on above
Section Plat

Name of Conservation Agent who supervised plugging of this well Gilbert Balthazor
Producing formation _____ Depth to top _____ Bottom _____ Total Depth of Well _____ Feet
Show depth and thickness of all water, oil and gas formations.

OIL, GAS OR WATER RECORDS

CASING RECORD

FORMATION	CONTENT	FROM	TO	SIZE	PUT IN	PULLED OUT
				8 5/8"	205.90'	None

Describe in detail the manner in which the well was plugged, indicating where the mud fluid was placed and the method or methods used in introducing it into the hole. If cement or other plugs were used, state the character of same and depth placed, from _____ feet to _____ feet for each plug set.

1st Plug was Set @ 900' with 70 sx.
2nd Plug was Set @ 200' with 20 sx.
3rd Plug was Set @ 40' with 10 sx.
Plug was down @ 3:00 a.m. November 20, 1975

RECEIVED
STATE CORPORATION COMMISSION
11-26-1975
NOV 26 1975

CONSERVATION DIVISION
Wichita, Kansas

(If additional description is necessary, use BACK of this sheet)
Name of Plugging Contractor Abercrombie Drilling, Inc.
Address 801 Union Center, Wichita, Kansas 67202

STATE OF KANSAS, COUNTY OF SEDGWICK, ss.
Jerry A. Langrehr-Exec. V.P. (employee of owner) or (owner or operator) of the above-described well, being first duly sworn on oath, says: That I have knowledge of the facts, statements, and matters herein contained and the log of the above-described well as filed and that the same are true and correct. So help me God.

(Signature) Jerry A. Langrehr
801 Union Center, Wichita, Kansas 67202
(Address)

SUBSCRIBED AND SWORN TO before me this 25th day of November, 1975

DR. JERRY RUSSELL
NOTARY PUBLIC

My commission expires

July 21, 1979

Sandra Russell

Notary Public.

15-195-20345-00-00

CONTRACTOR'S WELL LOG

OPERATOR:	John P. Jennings
CONTRACTOR:	Abercrombie Drilling, Inc.
WELL NAME:	GALLOWAY #1
LOCATION:	C W/2 SW/4 Sec. 10-11S-23W Trego County, Kansas
GEOLOGIST:	Don Strong
SPUD DATE:	November 13, 1975
COMPLETION DATE:	November 20, 1975

0	80	Soil, Clay & Sand
80	745	Shale
745	840	Sand
840	985	Shale
985	1050	Sand
1050	1250	Shale
1250	1475	Sand
1475	1734	Shale
1734	1774	Anhydrite
1774	2260	Shale
2260	3363	Lime and Shale
3363	3493	Lime
3493	3537	Lime & Shale
3537	3734	Lime
	3734	Rotary Total Depth

RECEIVED
 STATE COMMISSION OF MINES
 11-26-1975
 1975 26 11
 COMMISSIONER OF MINES
 Topeka, Kansas

Drilled 208' of 12½" hole. Ran 5 jts. of 8 5/8" casing, Set @ 205.90' K.B. Cemented with 165 sx. Quick-Set cement. Cement did circulate. Plug was down @ 4:00 p.m. November 13, 1975.

Plugged and Abandoned: 1st Plug was set @ 900' with 70 sx. cement; 2nd Plug was set @ 200' with 20 sx. cement; 3rd Plug was set @ 40' with 10 sx. cement. State Plugger: Gilbert Balthazor Plug was down @ 3:00 a.m. November 20, 1975.

SAMPLE TOPS:

Anhydrite 1734
 B/Anhydrite 1774

STATE OF KANSAS)
) SS
 COUNTY OF SEDGWICK)

Jerry A. Langrehr, Executive Vice President of Abercrombie Drilling, Inc., does hereby state that the above and foregoing is a true and correct copy of the log of the GALLOWAY #1, C W/2 SW/4 Section 10-11S-23W, Trego County, Kansas.

ABERCROMBIE DRILLING, INC.

By: Jerry A. Langrehr
 Jerry A. Langrehr-Exec. V.P.

Subscribed and sworn to before me, a Notary Public, in and for the aforesaid county and state as of this 25th day of November, 1975.

Sandra Russell
 Sandra Russell - Notary Public

My Commission Expires: July 21, 1979

