

CARD MUST BE TYPED

State of Kansas

CARD MUST BE SIGNED

NOTICE OF INTENTION TO DRILL

(see rules on reverse side)

Expected Spud Date... June 13 87
month day year

API Number 15- 195-21,916-00-00

OPERATOR: License # 8449
Name McNames & Patterson
Address P.O. Box 20058
City/State/Zip Wichita, Ks 67208
Contact Person Gary Patterson
Phone 733-5750

SW SE NE Sec. 10 Twp. 11 S, Rg. 23 X East
2970 Ft. from South Line of Section
990 Ft. from East Line of Section

(Note: Locate well on Section Plat on reverse side)

CONTRACTOR: License # ~~5655~~ 5655
Name Shields Drlg. Co, Inc
City/State Russell, Ks

Nearest lease or unit boundary line 330 feet
County Trego

Lease Name Denison Well # 1

Ground surface elevation 2249 feet MSL

Domestic well within 330 feet: no

Municipal well within one mile: no

Depth to bottom of fresh water 50

Depth to bottom of usable water 925

Surface pipe by Alternate: 1 2 X

Surface pipe planned to be set 2005

Conductor pipe required 925

Projected Total Depth 3750 feet

Formation Lansing-Kansas City

Well Drilled For: Well Class: Type Equipment:
X Oil Storage Infield X Mud Rotary
Gas Inj Pool Ext. Air Rotary
OWWO Expl X Wildcat Cable

If OWWO: old well info as follows:

Operator
Well Name
Comp Date Old Total Depth

I certify that well will comply with K.S.A. 55-101, et seq., plus eventually plugging hole to KCC specifications.

Date 5/14/87 Signature of Operator or Agent Gary Patterson Title Partner

For KCC Use:

Conductor Pipe Required 200 feet; Minimum Surface Pipe Required 200 feet per Alt. (2)


This Authorization Expires 11-19-87 Approved By 5-19-87

Must be filed with the K.C.C. five (5) days prior to commencing well
This card void if drilling not started within six (6) months of date received by K.C.C.

Important procedures to follow:

1. Notify District office before setting surface casing.
2. Set surface casing by circulating cement to the top.
3. File completion forms ACO-1 with K.C.C. within 120 days of well spud date, following instructions on ACO-1, side 1, and including copies of wireline logs.
4. Notify District office 48 hours prior to old well workover or re-entry.
5. Prior to filing Intent, prepare a proposed plugging plan in case well is D & A, then obtain approval of plan when calling district office prior to setting surface pipe.
6. Submit plugging report (CP-4) to K.C.C. after plugging is completed.
7. Obtain an approved injection docket number before disposing of salt water.
8. Notify K.C.C. within 10 days when injection commences or terminates.
9. If an alternate 2 completion, cement in the production pipe from below any usable water to surface within 120 days of spud date.

A Regular Section of Land 1 Mile = 5,280 Ft.

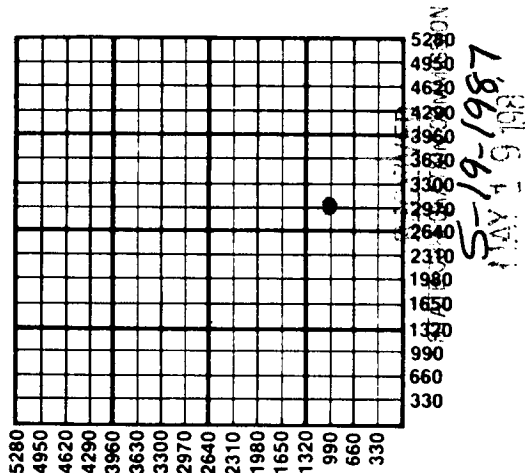

State Corporation Commission of Kansas
Conservation Division
200 Colorado Derby Building
Wichita, Kansas 67202-1212
(316) 263-3238