

NOTICE OF INTENTION TO DRILL

(see rules on reverse side)

✓ DO

Expected Spud Date. November 13, 1988
month day year

API Number 15-195-22,003-00-00

OPERATOR: License # 4569
Name Jay Boy Oil, Inc.
Address 100 N. Broadway, Suite 535
City/State/Zip Wichita, KS 67202

SE NW NE Sec. 10. Twp. 11. S, Rg. 23. X West
4290 Ft. from South Line of Section
1650 Ft. from East Line of Section

(Note: Locate well on Section Plat on reverse side)

Contact Person Gary Sharp
Phone (316) 264-3700

Nearest lease or unit boundary line 330 feet
County Trego

CONTRACTOR: License # 6033
Name Murfin Drilling
City/State Wichita, KS

Lease Name McCall Well # 1
Ground surface elevation feet MSL

Well Drilled For: Well Class: Type Equipment:
X Oil Storage Infield X Mud Rotary
Gas Inj X Pool Ext. Air Rotary
OWWO Expl Wildcat Cable

Domestic well within 330 feet: yes X no
Municipal well within one mile: yes X no

If OWWO: old well info as follows:

Depth to bottom of fresh water 70'
Depth to bottom of usable water 900'

Operator
Well Name
Comp Date Old Total Depth

Surface pipe by Alternate: 1 2 X
Surface pipe planned to be set 250' of .8-5/8"

I certify that well will comply with K.S.A. 55-101, et seq., plus eventually plugging hole to KCC specifications.

Date 10/24/88 Signature of Operator or Agent Charles Gore Title Controller

For KCC Use:

Conductor Pipe Required feet; Minimum Surface Pipe Required 200 feet per Alt. X 2

This Authorization Expires 4-24-89 Approved By R.H. 10-24-88


EFFECTIVE DATE: 10-29-88

Must be filed with the K.C.C. five (5) days prior to commencing well
This card void if drilling not started within six (6) months of date received by K.C.C.

Important procedures to follow:

1. Notify District office before setting surface casing.
2. Set surface casing by circulating cement to the top.
3. File completion forms ACO-1 with K.C.C. within 120 days of well spud date, following instructions on ACO-1, side 1, and including copies of wireline logs.
4. Notify District office 48 hours prior to old well workover or re-entry.
5. Prior to filing Intent, prepare a proposed plugging plan in case well is D & A, then obtain approval of plan when calling district office prior to setting surface pipe.
6. Submit plugging report (CP-4) to K.C.C. after plugging is completed.
7. Obtain an approved injection docket number before disposing of salt water.
8. Notify K.C.C. within 10 days when injection commences or terminates.
9. If an alternate 2 completion, cement in the production pipe from below any usable water to surface within 120 days of spud date.

A Regular Section of Land
1 Mile = 5,280 Ft.

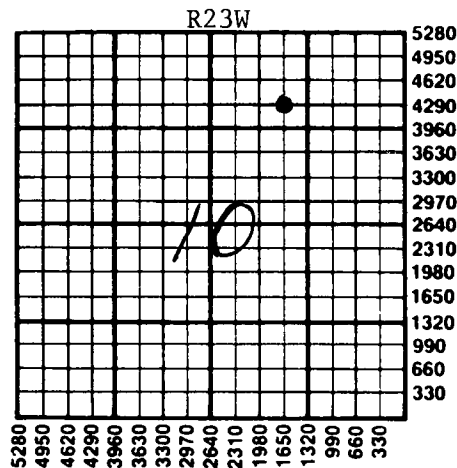

#1 McCall
SE NW NE Sec10 T11S R23W
Trego County, KS
Jay Boy Oil, Inc.

10-24-1988

State Corporation Commission of Kansas
Conservation Division
200 Colorado Derby Building
Wichita, Kansas 67202-1212
(316) 263-3238