

CARD MUST BE TYPED

State of Kansas

15-065-22489-0000

CARD MUST BE SIGNED

NOTICE OF INTENTION TO DRILL

CORRECTED CARD *
Vors

(see rules on reverse side)

Expected Spud Date.....5.....21.....88.....
month day year

API Number 15-065-22,459

✓ DA

OPERATOR: License #4964.....

* NW NE SE Sec. 28 Twp. 9 S, Rg. 25 East
West

Name DCF Exploration

Address 940 Wadsworth Blvd. - Suite 100

City/State/Zip Lakewood, Colorado 80215

Contact Person..... Douglas C. Frickey

Phone..... (303) 232-5011

CONTRACTOR: License #5107.....

Name H-30 Drilling, Inc.

City/State Wichita, Kansas 67202

Well Drilled For: Well Class: Type Equipment:

Oil Storage Infield Mud Rotary

Gas Inj Pool Ext. Air Rotary

OWWO Expl Wildcat Cable

If OWWO: old well info as follows:

Operator

Well Name

Comp Date Old Total Depth.....

I certify that well will comply with K.S.A. 55-101, et seq., plus eventually plugging hole to KCC specifications.

Date 5/11/88 Signature of Operator or Agent Douglas C. Frickey Title..... President

For KCC Use:

Conductor Pipe Required feet; Minimum Surface Pipe Required 200 feet per Alt. 2

This Authorization Expires 11-16-88 Approved By FCM 5-16-88 ; 7-6-88

AWAS: NE-NW-SE 1650' FEL

..... 2310 Ft. from South Line of Section

* 990 Ft. from East Line of Section

(Note: Locate well on Section Plat on reverse side)

Nearest lease or unit boundary line 330 feet

County..... Graham

Lease Name... Sauer "A" Well # 1

Ground surface elevation 2580 feet MSL

Domestic well within 330 feet:yes no

Municipal well within one mile:yes no

Depth to bottom of fresh water..... 180'

Depth to bottom of usable water 1400'

Surface pipe by Alternate: 1 2

Surface pipe planned to be set 200'

Conductor pipe required

Projected Total Depth 4500 feet


Formation..... Arbuckle

Must be filed with the K.C.C. five (5) days prior to commencing well
This card void if drilling not started within six (6) months of date received by K.C.C.

Important procedures to follow:

1. Notify District office before setting surface casing.
2. Set surface casing by circulating cement to the top.
3. File completion forms ACO-1 with K.C.C. within 120 days of well spud date, following instructions on ACO-1, side 1, and including copies of wireline logs.
4. Notify District office 48 hours prior to old well workover or re-entry.
5. Prior to filing Intent, prepare a proposed plugging plan in case well is D & A, then obtain approval of plan when calling district office prior to setting surface pipe.
6. Submit plugging report (CP-4) to K.C.C. after plugging is completed.
7. Obtain an approved injection docket number before disposing of salt water.
8. Notify K.C.C. within 10 days when injection commences or terminates.
9. If an alternate 2 completion, cement in the production pipe from below any usable water to surface within 120 days of spud date.

A Regular Section of Land
1 Mile = 5,280 Ft.

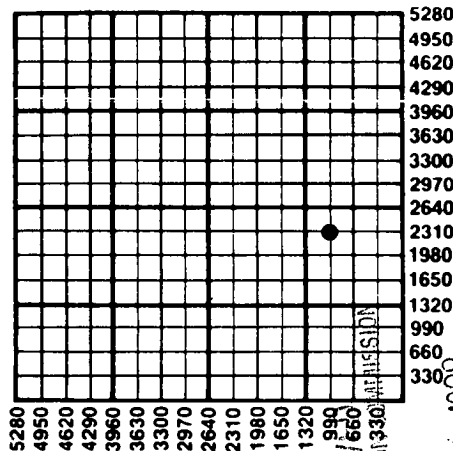

RECEIVED

STATE CORPORATION

ADMISSION

JUL 1 1988
7-1-88

CONSERVATION DIVISION
Wichita, Kansas

State Corporation Commission of Kansas
Conservation Division
200 Colorado Derby Building
Wichita, Kansas 67202-1212
(316) 263-3238