

CARD MUST BE TYPED

State of Kansas
NOTICE OF INTENTION TO DRILL
(see rules on reverse side)

CARD MUST BE SIGNED

Starting Date: July 14, 1984
month day year

API Number 15- 065-22,018-0000

OPERATOR: License # 5418
Name ALLEN DRILLING COMPANY
Address P.O. Box 1389
City/State/Zip Great Bend, KS 67530
Contact Person Doug Haisington
Phone 316/793-5877

N/2. N/2. NE Sec 28 Twp 9 S, Rge 25
(location) East West

4950 Ft North from Southeast Corner of Section
1320 Ft West from Southeast Corner of Section
(Note: Locate well on Section Plat on reverse side)

CONTRACTOR: License # 5418
Name Company tools
City/State

Nearest lease or unit boundary line 330 feet
County Graham
Lease Name SAUER Well# 1-28

Well Drilled For: Well Class: Type Equipment:
 Oil Swd Infield Mud Rotary
 Gas Inj Pool Ext. Air Rotary
 OWWO Expl Wildcat Cable

Domestic well within 330 feet: yes no
Municipal well within one mile: yes no

If OWWO: old well info as follows:

Operator NA
Well Name --
Comp Date -- Old Total Depth --
Projected Total Depth 4600 feet
Projected Formation at TD Cherokee
Expected Producing Formations Cherokee & LKC

Depth to Bottom of fresh water 1325 ^{MHC} feet
Lowest usable water formation Dakota
Depth to Bottom of usable water 1325 feet
Surface pipe by Alternate: 1 2
Surface pipe to be set 300 feet
Conductor pipe if any required NA feet
Ground surface elevation Appr 2550 feet MSL
This Authorization Expires 1/5/85
Approved By 7/5/84 *R*

I certify that we will comply with K.S.A. 55-101, et seq., plus eventually plugging hole to K.C.C. specifications.

Date 7/03/84 Signature of Operator or Agent *Doug Haisington*


Title Vice-President + Prod

MHC/KOHE 7-5-84

Must be filed with the K.C.C. five (5) days prior to commencing well
This card void if drilling not started within six (6) months of date received by K.C.C.

Important procedures to follow:

**A Regular Section of Land
1 Mile = 5,280 Ft.**

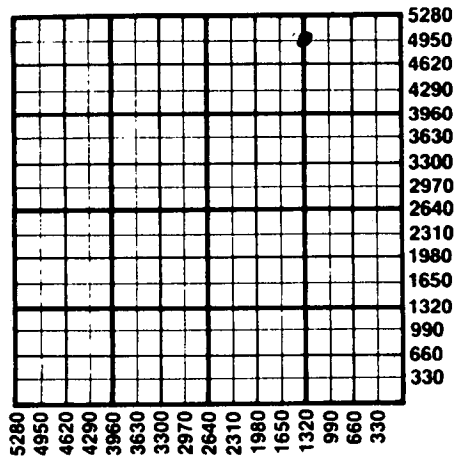

1. Notify District office before setting surface casing.
2. Set surface casing by circulating cement to the top.
3. File completion forms ACO-1 with K.C.C. within 90 days of well completion, following instructions on ACO-1, side 1, and including copies of wireline logs.
4. Notify District office 48 hours prior to old well workover or re-entry.
5. Prior to plugging, prepare a plugging plan, then obtain agreement from the appropriate district office for an approved plugging plan.
6. Submit plugging report (CP-4) to K.C.C. after plugging is completed.
7. Obtain an approved injection docket number before disposing of salt water.
8. Notify K.C.C. within 10 days when injection commences or terminates.
9. If an alternate 2 completion, cement in the production pipe from below any usable water to surface within 120 days of spud date.

State Corporation Commission of Kansas
Conservation Division
200 Colorado Derby Building
Wichita, Kansas 67202
(316) 263-3238

RECEIVED
STATE CORPORATION COMMISSION
WICHITA, KANSAS
MAY 05 1984
7-5-84