

Give All Information Completely
Make Required Affidavit
Mail or Deliver Report to:
Conservation Division
State Corporation Commission,
800 Bitting Building
Wichita, Kansas

11-12-1936

Ha

FORMATION PLUGGING RECORD

OR

Strike out upper line when reporting plugging off formations.

NORTH

**Locate well correctly on above
Section Plat**

Location as "NE1/4NW1/4SW1/4" of footage from lines Trigo County, Sec. 7, Twp. 11, Rge. 22(E) (W)
NW1/4 of S24 1/4

Lease Owner: R. B. McNeely & Rose Spring Shelling Co.

Lease Name Tempe Well No. 11

Office Address Little Singleton Bldg Wichita, Kansas
Character of Well (Completed as Oil, Gas or Dry Hole) Dry Hole

Date, well completed.....193.....

Application for plugging filed October - 20 1936

Application for plugging approved.....November 4.....1936

Plugging Commenced..... October 20 1936

Plugging Completed.....*November 4*.....193*4*

Reason for abandonment of well or producing formation.....dry

If a producing well is abandoned, date of last production.....193.....

Was permission obtained from the Conservation Division or its agents before plugging was commenced?

Name of Conservation Agent who supervised plugging of this well Mr. Alexander

Producing formation..... Depth to top..... Bottom..... Total Depth of Well 40.30 Feet


Show depth and thickness of all water, oil and gas formations. (taken from file)

OIL, GAS OR WATER RECORDS

CASING RECORD *Repa*[illegible]

Describe in detail the manner in which the well was plugged, indicating where the mud fluid was placed and the method or methods used in introducing it into the hole. If cement or other plugs were used, state the character of same and depth placed, from _____ feet to _____ feet for each plug set.

Hole was pumped full of mud to bottom of surface pipe and was bridged in bottom of surface pipe then cemented with 10 sacks of cement. Hole was then filled with mud to bottom of cellar. The bottom of cellar was then cemented.

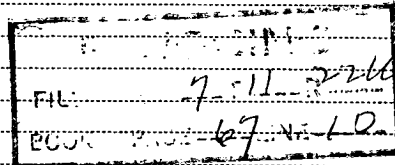

(If additional description is necessary use BACK of this sheet)

Correspondence regarding this well should be addressed to.....
Address.....

STATE OF Kansas, COUNTY OF Edwards, ss.

.....(employee of owner) or (owner or operator) of the above-described well,
being first duly sworn on oath, says: That I have knowledge of the facts, statements, and matters herein contained and the log of the above-described
well as filed and that the same are true and correct. So help me God. *The Rose Spring Drilling Co.*

(Signature) By A M Lerafin

(Address)

SUBSCRIBED AND SWORN TO before me this 10th day of November 1936

My commission expires Nov-1-1937

16-5344 10-36-5M

Notary Public.

Lemke # 1

15-195-01463-00-00


SW1/4 Sec. 7-11S-2W
Trego, Kansas

Drilled for: Robert B. McNeeley and
The Rose Spring Drilling Company
Drilled by: The Rose Spring Drilling Company

Casing Record:
10" 110'
6 5/8" --3490'

Drilling Commenced: July 19, 1936
Drilling Completed: October 25, 1936

<u>FORMATION</u>	<u>DEPTH</u>	<u>FORMATION</u>	<u>DEPTH</u>
river sand	72	lime	3235
shale	75	broken lime	3300
shale & lime shells	110	lime	3385
shale	585	lime & shale	3468
lime shale	692	sandy lime	3525
sand	775	lime	3534
sand & lime	787	light chert	3542
sandy shale	940	lime	3544
sand	985	grey lime	3546
lime	990	shale	3547
sandy lime	1060	white lime	3550
lime & shale	1190	hard lime	3554
sand & red rock	1395	lime	3557
redbed & shale	1640	hard lime	3563
lime & shale	1665	blue shale	3567
lime	1685	shale	3584
lime & shale	1709	broken lime	3588
anhydrite	1750	lime	3611
shale	1845	shale	3625
shale & lime	2030	broken lime	3630
shale	2165	shale	3644
lime & shale	2238	lime	3646
lime	2286	broken lime	3650
shale & lime	2439	lime	3658
broken lime	2483	lime break & red rock	
lime & shale	2522	lime	
broken lime	2576	broken shale	
lime	2635	shale	
green shale	2663	lime	
soft lime	2714	shale	
broken lime	2735	shale & lime	
sandy lime	2750	sandy lime	
lime & shale	2810	lime & chert	
lime	2835	chert	
lime & shale	2852	shale & lime	
lime	2972	shale	
grey shale	3004	conglomerate	
sticky gray shale	3020	white lime	
shale & lime	3140	lime	
		sandy lime	
		lime	

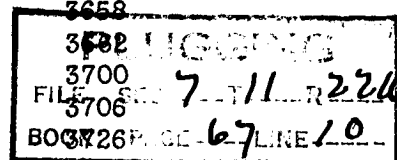

State of Kansas
County of Sedgwick, SS

I, the undersigned, being duly sworn on oath, state that the above and within statement is a true and correct record and log of the well drilled on the location above described, to the best of my knowledge and belief.

Subscribed and sworn to before me this 10th day of Feb'y 1937.

Notary Public

My Commission Expires Nov-1-1937