


15-195-20457-00-00

STATE OF KANSAS
STATE CORPORATION COMMISSION

WELL PLUGGING RECORD

Give All Information Completely
Make Required Affidavit
Mail or Deliver Report to
Conservation Division
State Corporation Comm.
245 North Water
Wichita, KS 67202

Trego County, Sec. 8 Twp. 11S Rge. 22 E/W
Location as "NE/CNW $\frac{1}{4}$ /SW $\frac{1}{4}$ " or footage from lines
NW NW NW
Lease Owner F & M Oil Co.
Lease Name Baughman Well No. 1
Office Address 505 Union Center, Wichita, Kansas 67202
Character of Well (Completed as Oil, Gas or Dry Hole) Dry Hole

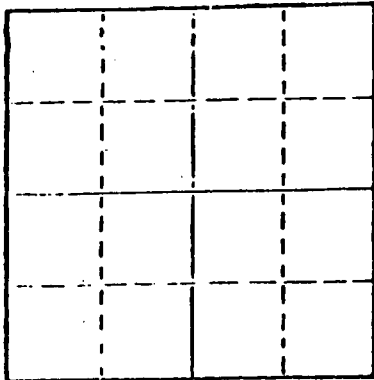

Locate well correctly on above
Section Plat

Date Well completed Jan. 29 1978
Application for plugging filed (verbally) Jan. 29 1978
Application for plugging approved (verbally) Jan. 29 1978
Plugging commenced Jan. 29 1978
Plugging completed Jan. 29 1978
Reason for abandonment of well or producing formation
No commercial quantity of oil or gas encountered
If a producing well is abandoned, date of last production 19

Was permission obtained from the Conservation Division or
its agents before plugging was commenced? Yes

Name of Conservation Agent who supervised plugging of this well Gilbert Balthazor
Producing formation Depth to top Bottom Total Depth of Well 3760
Show depth and thickness of all water, oil and gas formations.

OIL, GAS OR WATER RECORDS

CASING RECORD

FORMATION	CONTENT	FROM	TO	SIZE	PUT IN	PULLED OUT

Describe in detail the manner in which the well was plugged, indicating where the mud fluid was placed and the method or methods used in introducing it into the hold. If cement or other plugs were used, state the character of same and depth placed, from feet to feet for each plug set.

Set 1st plug at 700' with 70 sacks
2nd plug at 200' with 20 sacks
40' solid bridge with 10 sacks
Cemented with 50/50 posmix, 6% gel
Plug was down at 12:00 noon, January 29, 1978

RECEIVED
STATE CORPORATION COMMISSION
2-7-1978
FEB 07 1978

CONSERVATION DIVISION
Wichita, Kansas


(If additional description is necessary, use BACK of this sheet)

Name of Plugging Contractor Abercrombie Drilling, Inc.

STATE OF Kansas COUNTY OF Sedgwick, ss.
Jack L. Partridge, Ass't. Sec.-Treas. (employee of owner) or (owner or operator)
of the above-described well, being first duly sworn on oath, says: That I have knowledge of the facts, statements, and matters herein contained and the log of the above-described well as filed and that the same are true and correct. So help me God.

(Signature) Jack L. Partridge
801 Union Center, Wichita, Kansas 67202
(Address)

SUBSCRIBED AND SWORN TO before me this 3rd day of February, 1978

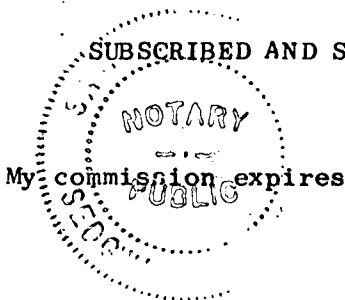

Sandra Richman
Sandra Richman Notary Public.

My commission expires July 21, 1979

CONTRACTOR'S WELL LOG 15-195-20457-00-00

OPERATOR: F & M Oil Co.
 CONTRACTOR: Abercrombie Drilling, Inc.
 WELL NAME: Baughman #1
 LOCATION: NW NW NW Section 8-11S-22W
 Trego County, Kansas
 SPUD DATE: January 21, 1978
 COMPLETION DATE: January 29, 1978

0	200	Clay & sand
200	218	Shale
218	1720	Shale & sand
1720	1758	Anhydrite
1758	2384	Shale
2384	2565	Shale & lime
2565	2624	Lime & shale
2624	2805	Shale & lime
2805	3541	Lime & shale
3541	3760	Lime
	3760	Rotary Total Depth

Spud hole at 7:15 p.m., January 21, 1978. Drilled 218' of 12 1/4" hole. Ran 6 joints of 8-5/8" surface casing. Set at 217' K.B. Cemented with 175 sacks Common cement, 3% CaCl, 2% gel. Plug was down at 10:30 p.m., January 21, 1978. Cement did circulate.

T.D. 3670'. Set 1st plug at 700' with 70 sacks, 2nd plug at 200' with 20 sacks, 40' solid bridge with 10 sacks. Cemented with 50/50 posmix, 6% gel. Plug was down at 12:00 noon, January 29, 1978. State Plugger - Gilbert Balthazor.

SAMPLE TOPS:

Anhydrite 1719'
 B/Anhydrite 1758'

RECEIVED
 STATE OF KANSAS COMMISSION

FEB 07 1978

2-7-1978

STATE OF KANSAS)
) ss
 COUNTY OF SEDGWICK)


COMMISSION
 Wichita, Kansas

Jack L. Partridge, Assistant Secretary-Treasurer of Abercrombie Drilling, Inc., does hereby state that the above and foregoing is a true and correct copy of the log of the Baughman #1, NW NW NW Section 8-11S-22W, Trego County, Kansas.

ABERCROMBIE DRILLING, INC.

By Jack L. Partridge
 Jack L. Partridge, Ass't. Sec.-Treas.

Subscribed and sworn to before me, a Notary Public, in and for the county and state aforesaid, as of this 3rd day of February, 1978.

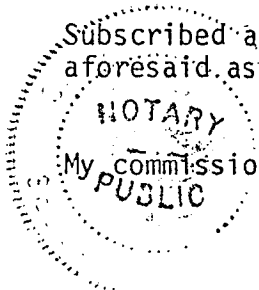

My commission expires July 21, 1979.

Sandra Richman
 Sandra Richman, Notary Public