


STATE OF KANSAS  
STATE CORPORATION COMMISSION

Give All Information Completely  
Make Required Affidavit  
Mail or Deliver Report to:  
Conservation Division  
State Corporation Commission  
211 No. Broadway  
Wichita, Kansas

15-051-00752-00-00

WELL PLUGGING RECORD

NORTH

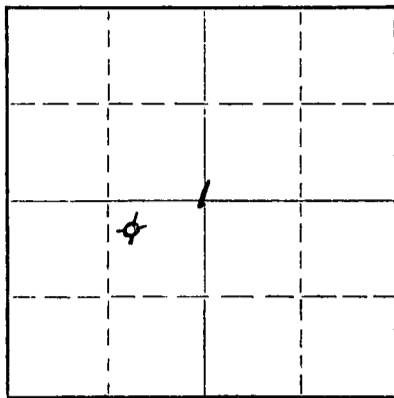

Locate well correctly on above  
Section Plat

Ellis County, Sec. 1 Twp. 11 Rge. (X) 20 (W)  
Location as "NE/CNW/SW" or footage from lines NW NE SW  
Lease Owner Thos. H. Allan, et al  
Lease Name Frank Armbrister Well No. 1  
Office Address 925 Union Center, Wichita 2, Kansas  
Character of Well (completed as Oil, Gas or Dry Hole) Dry Hole  
Date well completed October 19 19 58  
Application for plugging filed October 19 19 58  
Application for plugging approved October 19 19 58  
Plugging commenced October 19 19 58  
Plugging completed October 19 19 58  
Reason for abandonment of well or producing formation Dry Hole

If a producing well is abandoned, date of last production 19  
Was permission obtained from the Conservation Division or its agents before plugging was commenced? Yes

Name of Conservation Agent who supervised plugging of this well Eldon Petty  
Producing formation Lansing-Kansas City Depth to top 3361 Bottom 3578 Total Depth of Well 3584 Feet  
Show depth and thickness of all water, oil and gas formations.

OIL, GAS OR WATER RECORDS

CASING RECORD

FORMATION	CONTENT	FROM	TO	SIZE	PUT IN	PULLED OUT
				8 5/8"	252	None

Describe in detail the manner in which the well was plugged, indicating where the mud fluid was placed and the method or methods used in introducing it into the hole. If cement or other plugs were used, state the character of same and depth placed, from feet to feet for each plug set.

3584 - 550 Heavy Rotary Mud  
550 - 500 Wood Plug and 20 sacks of cement through drill pipe  
500 - 180 Heavy Mud  
180 - 150 Bridge of sack of hulls, rock, and 15 sacks of cement  
150 - 45 Mud  
45 - Surface Bridge of sack of hulls, rock, and 10 sacks of cement

(If additional description is necessary, use BACK of this sheet)

Name of Plugging Contractor Thos. H. Allan  
Address 925 Union Center, Wichita 2, Kansas

STATE OF KANSAS, COUNTY OF SEDGWICK, ss.  
Thos. H. Allan (owner or operator) of the above-described

well, being first duly sworn on oath, says: That I have knowledge of the facts, statements, and matters herein contained and the log of the above-described well as filed and that the same are true and correct. So help me God.

(Signature) Thos. H. Allan  
925 Union Center, Wichita 2, Kansas  
(Address)

SUBSCRIBED AND SWORN TO before me this 21st day of October, 19 58

Ocie M. Stewart  
Notary Public.

My commission expires June 14, 1962

PLUGGING  
FILE SEC 1 T 11 R 20W  
BOOK PAGE 139 LINE 21

RECEIVED  
STATE CORPORATION COMMISSION  
10-25-1958  
OCT 25 1958  
CONSERVATION DIVISION  
Wichita, Kansas

15-051-00752-00-00

8 5/8" @ 252' - 150 Sx, Circ.

ALLAN, et al - #1 FRANK ARMBRISTER  
NW NE SW 1-11-20W  
Ellis County, Kansas  
COM: 10/9/58 COMPL: 10/19/58  
CONTRACTOR: Tom Allan  
ELEV: 2091 RB

I.P. D & A

All Depths from Rotary Bushings

0 - 10 Soil  
50 Lime Rock  
120 Chalky Lime  
252 Blue Gumbo  
350 Shale  
400 Lime & Shale  
500 Shale  
850 Shale & Sand Streaks  
1100 Sandstone & Sdy. Shale  
1490 Red Beds  
1536 Anhydrite  
1750 Red Shale  
1850 Shale  
2000 Salt & Shale  
2300 Shale & Shells  
2375 Lime  
2400 Cherty Lime  
2525 Shale  
2600 Lime  
3106 Shale & Shells  
3150 Lime  
3175 Shale  
3198 Lime  
3218 Shale  
3244 Lime  
3252 Shale  
3286 Lime  
3300 Shale  
3324 Lime  
3327 Black Shale  
3331 Lime  
3348 Shale  
3354 Lime  
3361 Red Shale  
3386 Cherty Lime  
3396 Shale  
3412 Lime  
3416 Shale  
3428 Lime  
3436 Shale  
3460 Lime  
3475 Cherty Lime  
3483 Lime  
3485 Black Shale  
3489 Lime  
3494 Shale  
3510 Cherty Lime  
3516 Shale

3578 Lime & Shale Breaks  
3584 (T.D.) Red Silty Shale

FORMATION TOPS:

1490 (+ 601) Anhydrite  
3106 (-1015) Topeka  
3324 (-1233) Heebner  
3348 (-1257) Brown Lime  
3361 (-1270) Lansing  
3578 (-1487) Base Kansas City

I certify that this is a true and correct copy of the well log.

Tom Allan

Subscribed and sworn to before me this 24th day of October, 1958.

Ocie M. Stewart

My commission expires June 14, 1962.

PLUGGING  
FILE SEC. 11 R. 20W  
PAGE 139 LINE 21

RECEIVED  
OCT 25 1958  
CONSERVATION DIV.  
Wichita, Kansas