


15-051-00255-00-00

WELL PLUGGING RECORD

STATE OF KANSAS  
STATE CORPORATION COMMISSION  
Give All Information Completely  
Make Required Affidavit  
Mail or Deliver Report to:  
Conservation Division  
State Corporation Commission  
800 Bitting Building  
Wichita, Kansas

NORTH

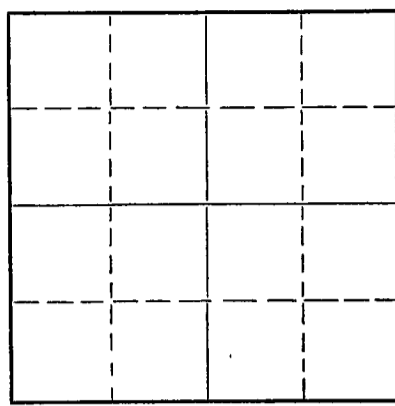

Locate well correctly on above  
Section Plat

Ellis County. Sec. 1 Twp. 11 Rge. 20 (E) W (W)  
Location as "NE/CNW&SW" or footage from lines SW SW NW  
Lease Owner Trans Era Petroleum, Inc.  
Lease Name Keller "B" Well No. 1  
Office Address Russell, Kansas  
Character of Well (completed as Oil, Gas or Dry Hole) Dry  
Date well completed 5/18/53 19  
Application for plugging filed 5/16/53 19  
Application for plugging approved 5/16/53 19  
Plugging commenced 5/17/53 19  
Plugging completed 5/17/53 19  
Reason for abandonment of well or producing formation Dry Hole

If a producing well is abandoned, date of last production 19  
Was permission obtained from the Conservation Division or its agents before plugging was commenced? Yes

Name of Conservation Agent who supervised plugging of this well Eldon Petty  
Producing formation Depth to top Bottom Total Depth of Well 3773 Feet  
Show depth and thickness of all water, oil and gas formations.

OIL, GAS OR WATER RECORDS

CASING RECORD

FORMATION	CONTENT	FROM	TO	SIZE	PUT IN	PULLED OUT
				8 5/8"	206	None

Describe in detail the manner in which the well was plugged, indicating where the mud fluid was placed and the method or methods used in introducing it into the hole. If cement or other plugs were used, state the character of same and depth placed, from feet to feet for each plug set.

PLUGGING RECORD

Finished laying down drill pipe. Filled hole with heavy mud to 200', set bottom plug at 200' with 15 sacks of cement mixed and run through drill pipe. Filled hole with heavy mud to 40', set top plug at 40' together with 1/2 sack of hulls and 10 sacks of cement. Top plug was wired to surface pipe.

RECEIVED  
MAY 23 1953  
CONS. DIV. WICHITA, KANSAS

(If additional description is necessary, use BACK of this sheet)

Name of Plugging Contractor  
Address

STATE OF KANSAS, COUNTY OF RUSSELL, ss.  
Herbert R. Michaelis (employee of owner) or (owner or operator) of the above-described well, being first duly sworn on oath, says: That I have knowledge of the facts, statements, and matters herein contained and the log of the above-described well as filed and that the same are true and correct. So help me God.

(Signature) *HR Michaelis*  
Russell, Kansas  
(Address)

SUBSCRIBED AND SWORN TO before me this 22nd day of May, 19 53

*Margie Cooper*  
Notary Public.

My commission expires 1-30-57.

PLUGGING  
FILE SEC 1 T 11 R 20W  
BOOK PAGE 101 LINE 39

15-051-00255-00-00

Trans Era Petroleum, Inc.  
Keller "B" #1

SW SW NW 1-11-20  
Ellis County, Ks.

Total Depth: 3773'  
Comm. 5/6/53  
Comp. 5/18/53

Casing

8 5/8" Set @ 206'

Cement

130 sacks Lone Star

Formation	Depth
Surface soil-clay	40
Shale-shells	209
Surface clay	425
Shale-shells	617
Shale	700
Sand	780
Shale-shells	1050
Sand	1250
Shale	1400
Red bed	1535
Anhydrite	1580
Shale	1864
Shale-lime	2950
Shale	2995
Shale-lime	3453
Lime	3673
Conglomerate	3765
Arbuckle Lime	3773'

RECEIVED  
5-23-1953

STATE OF KANSAS )  
                          ) ss  
RUSSELL COUNTY )

I hereby certify that the above information is true and correct  
to the best of my knowledge.

-----  
*Cora Betz*  
-----

Subscribed and sworn to before me this 22nd day of May, 1953.

-----  
*Margie Cooper*  
-----  
Notary Public

My commission expires: 1-30-57.

PLUGGING  
FILE SEC 1 T 11 R 20W  
BOOK PAGE 101 LINE 22