


STATE OF KANSAS  
STATE CORPORATION COMMISSION

15-051-00254-00-00  
WELL PLUGGING RECORD

Give All Information Completely  
Make Required Affidavit  
Mail or Deliver Report to:  
Conservation Division  
State Corporation Commission  
800 Bittling Building  
Wichita, Kansas

Ellis County, Sec. 3 Twp. 11 Rge. 20 (E) (W)

NORTH

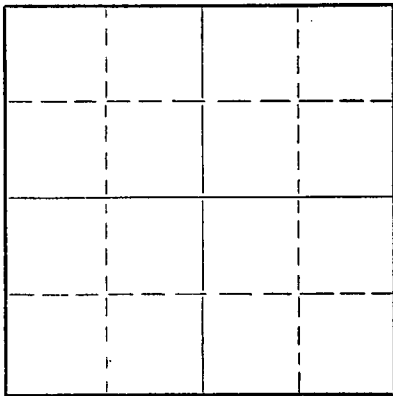

Locate well correctly on above  
Section Plat

Location as "NE/CNW/SW" or footage from lines NE NE NW  
Lease Owner The Veeder Supply & Development Co., et al  
Lease Name Fisher Well No. 1  
Office Address P. O. Box 201, Cherryvale, Kansas  
Character of Well (completed as Oil, Gas or Dry Hole) Dry Hole  
Date well completed June 8, 19 53  
Application for plugging filed June 8 19 53  
Application for plugging approved June 8 19 53  
Plugging commenced June 8 19 53  
Plugging completed June 8 19 53  
Reason for abandonment of well or producing formation Dry Hole

If a producing well is abandoned, date of last production \_\_\_\_\_ 19\_\_\_\_  
Was permission obtained from the Conservation Division or its agents before plugging was commenced? Yes

Name of Conservation Agent who supervised plugging of this well Eldon Petty  
Producing formation \_\_\_\_\_ Depth to top \_\_\_\_\_ Bottom \_\_\_\_\_ Total Depth of Well 3813 Feet  
Show depth and thickness of all water, oil and gas formations.

OIL, GAS OR WATER RECORDS

CASING RECORD

FORMATION	CONTENT	FROM	TO	SIZE	PUT IN	PULLED OUT
				8 5/8	200'	

Describe in detail the manner in which the well was plugged, indicating where the mud fluid was placed and the method or methods used in introducing it into the hole. If cement or other plugs were used, state the character of same and depth placed, from \_\_\_\_\_ feet to \_\_\_\_\_ feet for each plug set.

Plug set at 190' 15 sacks of cement on top of plug. Hole filled to 40' with mud. Set top plug and put 10 sacks of cement on plug.

RECEIVED  
STATE CORPORATION COMMISSION  
JULY 11 1953  
CONSERVATION DIVISION  
WICHITA, KANSAS

(If additional description is necessary, use BACK of this sheet)  
Name of Plugging Contractor The Veeder Supply & Development Company  
Address P. O. Box 201, Cherryvale, Kansas

STATE OF Kansas, COUNTY OF Montgomery, ss.  
Floyd W. Hild (employee of owner) or (~~owner or operator~~) of the above-described well, being first duly sworn on oath, says: That I have knowledge of the facts, statements, and matters herein contained and the log of the above-described well as filed and that the same are true and correct. So help me God.

(Signature) Floyd W. Hild  
Cherryvale, Kansas  
(Address)

SUBSCRIBED AND SWORN TO before me this 10th day of June, 19 53  
Oles Lawson  
Notary Public.

My commission expires July 11, 1953

PLUGGING  
FILE SEC 3 T 11 R 20W  
BOOK PAGE 107 LINE 4

15-051-00254-00-00

Company Veeder Supply & Development Co., et al

Sec. 3 T. 11 R. 20W

Farm Fisher

No. 1

Loc. NE NE NW

County Ellis

Total Depth 3813'

Comm. May 29, 1953

Comp. June 8, 1953

Shot or Treated


Contractor Veeder Supply & Development Co.

Issued

Casing

Set 200' of 8 5/8 casing  
Cemented with 125 sacks cement.

20 in.	10 in
15 1/2	8 1/4
12 1/2	6 5/8
13 3/8	5 3/16

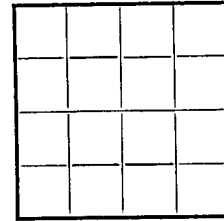

Elevation

Production dry

Figures Indicate Bottom of Formation

Soil clay	0	40	40
gray shale	40	120	80
Blue shale	120	200	80
Shale	200	665	465
Shale shells	665	1060	395
Sand	1060	1250	190
Shale shells	1250	1530	280
Anhydrite	1530	1570	40
Shale shells	1570	2200	630
Lime shells shale	2200	2310	110
Lime shale	2310	2445	135
Lime	2445	2500	55
Lime shale	2500	2615	115
Lime shale shells	2615	2775	160
Lime shale	2775	2920	145
Lime shale shells	2920	3135	215
Lime	3135	3690	555
Conglomerate	3690	3813	120

Plugged @ 190' with 15 sacks cement.

Plugged @ 40' with 10 sacks cement.

**PLUGGING**  
 FILE SEC 3 T 11 R 20W  
 PAGE 107 LINE 11

**RECEIVED**  
 STATE CORPORATION COMMISSION  
 6-11-1953  
 OIL AND GAS  
 COMPLETION DIVISION  
 WICHITA, KANSAS