


15-051-01200-00-00

WELL PLUGGING RECORD

Give All Information Completely
Make Required Affidavit
Mail or Deliver Report to:
Conservation Division
State Corporation Commission
800 Bitting Building
Wichita, Kansas

NORTH

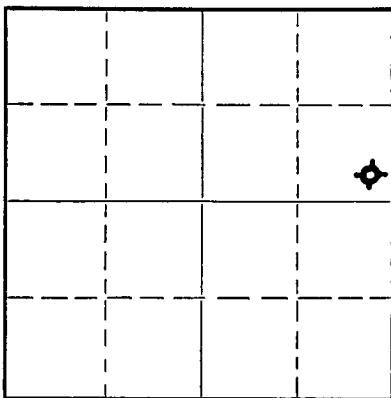

Locate well correctly on above Section Flat

Ellis County. Sec. 4 Twp. 11S Rge. (E) 20 (W)
Location as "NE/CNW $\frac{1}{4}$ /SW $\frac{1}{4}$ " or footage from lines SE SE NE
Lease Owner Brooks Pierce et al
Lease Name Veatch Well No. 1
Office Address 1208 Union Nat'l Bank Bldg., Wichita, Kansas
Character of Well (completed as Oil, Gas or Dry Hole) Dry Hole
Date well completed November 12 1950
Application for plugging filed 19
Application for plugging approved 19
Plugging commenced November 12 1950
Plugging completed November 12 1950
Reason for abandonment of well or producing formation Dry Hole

If a producing well is abandoned, date of last production 19
Was permission obtained from the Conservation Division or its agents before plugging was commenced?

Name of Conservation Agent who supervised plugging of this well
Producing formation Depth to top Bottom Total Depth of Well 3741 Feet
Show depth and thickness of all water, oil and gas formations.

OIL, GAS OR WATER RECORDS

CASING RECORD

Formation	Content	From	To	Size	Put In	Pulled Out
Surface Pipe				8-5/8"	194'	None

Describe in detail the manner in which the well was plugged, indicating where the mud fluid was placed and the method or methods used in introducing it into the hole. If cement or other plugs were used, state the character of same and depth placed, from feet to feet for each plug set.

Filled hole with heavy mud to 185'. Set plug; used 15 sack cement.
Filled hole to 40'. Set plug and cemented with 10 sacks cement.

RECEIVED
11-17-1950

(If additional description is necessary, use BACK of this sheet)
Correspondence regarding this well should be addressed to Brooks Pierce Drilling Company
Address 1208 Union Nat'l Bank Building
Wichita 2, Kansas

STATE OF Kansas, COUNTY OF Sedgwick, ss.

(employee of owner) or (owner or operator) of the above-described well, being first duly sworn on oath, says: That I have knowledge of the facts, statements, and matters herein contained and the log of the above-described well as filed and that the same are true and correct. So help me God.

(Signature) Brooks Pierce
1208 Union Nat'l Bank Bldg., Wichita, Kansas
(Address)

SUBSCRIBED AND SWORN TO before me this 14th day of November 19 50

My commission expires September 8, 1954.
Lorraine A. Bowman
Notary Public.

PLUGGING
FILE SEC 4 T 11 R 20W
BOOK PAGE 43 LINE 5

15-051-01200-00-00

BROOKS PIERCE DRILLING COMPANY
 UNION NATIONAL BANK BUILDING
 WICHITA 2, KANSAS

WELCH NO. 1
 SE SE NE of Section 4-11S-20W
 Ellis County, Kansas

<u>Formation</u>	<u>From</u>	<u>To</u>	<u>Remarks</u>
Sand	0	25	8-5/8" Surface Pipe @ 194', cemented with 150 sacks.
Shale	25	194	
Shale	194	290	
Shale & Shells	290	630	
Sand	630	705	
Sand, Shale & Shells	705	945	
Sand	945	1150	
Sand, Shale & Shells	1150	1220	
Red Bed & Shale	1220	1460	
Anhydrite	1460	1500	
Shale	1500	1565	
Shale & Shells	1565	2060	
Lime	2060	2310	
Lime & Shale	2310	2500	
Shale & Shells	2500	2625	
Lime & Shale	2625	2825	
Shale	2825	2825	
Shale, Lime & Sand	3090	3175	
Lime	3175	3560	
Shale & Lime	3560	3590	
Conglomerate	3590	3708	
Arbuckle	3708	3741	Plugged.
Total Depth		3741'	

I hereby certify the foregoing to be a true and accurate Driller's Log of the formations encountered in the above well.

BROOKS PIERCE DRILLING COMPANY

By Brooks Pierce
 Brooks Pierce, Owner
 REL
 STATE CORPORATION

Subscribed and sworn to before me this 14th day of November, 1950.

PLUGGING
 FILE SEC 4 T 11 R 20W
 BOOK PAGE 43 LINE 5

NOV 17 1950
Louise K. Bowman
 Notary Public

My Commission expires September 8, 1954.