

STATE OF KANSAS
STATE-CORPORATION COMMISSION


Give All Information Completely
Make Required Affidavit
Mail or Deliver Report to:
Conservation Division
State Corporation Commission
800 Bitting Building
Wichita, Kansas

OR

FORMATION PLUGGING RECORD

Strike out upper line
when reporting plug-
ging off formations.

NORTH

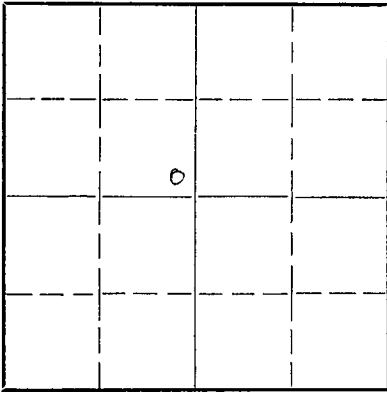

Locate well correctly on above
Section Plat

Ellis County, Sec. 9 Twp. 11S Rge. 20 (W)

Location as "NE $\frac{1}{4}$ NW $\frac{1}{4}$ SW $\frac{1}{4}$ " or footage from lines SE $\frac{1}{4}$ SE $\frac{1}{4}$ NW

Lease Owner C. C. Nelson Drilling Company

Lease Name Fischer Well No. 1

Office Address 508 Wolcott Bldg. Hutchinson, Kansas

Character of Well (completed as Oil, Gas or Dry Hole) Dry hole

Date well completed February 27 19 44

Application for plugging filed February 27 19 44

Application for plugging approved February 27 (oral) 19 44

Plugging commenced February 27 19 44

Plugging completed February 27 19 44

Reason for abandonment of well or producing formation Dry

If a producing well is abandoned, date of last production 19

Was permission obtained from the Conservation Division or its agents before plugging was com-
menced? Yes

Name of Conservation Agent who supervised plugging of this well C. T. Alexander

Producing formation Depth to top Bottom Total Depth of Well 3689 Feet

Show depth and thickness of all water, oil and gas formations.


OIL, GAS OR WATER RECORDS

CASING RECORD

Formation	Content	From	To	Size	Put In	Pulled Out
				10"	219'	None

Describe in detail the manner in which the well was plugged, indicating where the mud fluid was placed and the method or methods used in introducing it into the hold. If cement or other plugs were used, state the character of same and depth placed, from _____ feet to _____ feet for each plug set.

The hole was filled with heavy mud from 3689' to 219'. Hole cemented by Halliburton with 35 sacks of cement in surface pipe. Finished filling hole with heavy mud to top of surface and welded steel plate on top of surface pipe.

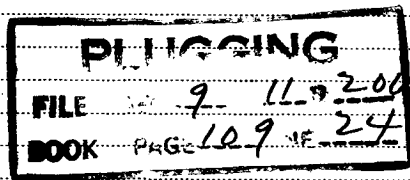

(If additional description is necessary, use BACK of this sheet)

Correspondence regarding this well should be addressed to C. C. Nelson Drilling Company
Address 508 Wolcott Bldg. Hutchinson, Kansas

STATE OF Kansas, COUNTY OF Reno, ss.
C. C. Nelson (employee of owner) or (owner or operator) of the above-described well,

being first duly sworn on oath, says: That I have knowledge of the facts, statements, and matters herein contained and the log of the above-described well as filed and that the same are true and correct. So help me God.

(Signature) C. C. Nelson

Hutchinson, Kansas (Address)

SUBSCRIBED AND SWORN to before me this 29th day of February, 19 44

My commission expires My Commission Expires March 25th, 1946.

Ernest W. Sage Notary Public.



3-1-1944

15-057-01412-00-00

COMPANY: C. C. Nelson Drilling Company
 CONTRACTOR: C. C. Nelson Drilling Company
 FARM: Fischer #1
 LOCATION: Section 9-11S-20W SE SE/4 NW
 Ellis County, Kansas
 COMMENCED: February 6, 1944
 COMPLETED: February 27, 1944

0	to	45	Sand
45	to	130	Shale
130	to	1125	Shale
1125	to	1207	Shale and sand
1207	to	1325	Shale and shells
1325	to	1535	Anhydrite and shale
1535	to	1680	Shale and shells
1680	to	1900	Shale
1900	to	2000	Shale and lime
2000	to	2480	Lime
2480	to	2540	Lime-broken
2540	to	2700	Shale and lime
2700	to	2765	Lime
2765	to	2820	Shale and lime
2820	to	2890	Shale
2890	to	2945	Shale and lime
2945	to	2990	Lime
2990	to	3005	Shale
3005	to	3050	Lime
3050	to	3125	Shale and lime
3125	to	3260	Lime
3260	to	3310	Shale and lime
3310	to	3395	Lime
3395	to	3435	K.C. Lime
3435	to	3579	Lime
3579	to	3607	Shale
3607	to	3636	Conglomerate
3636	to	3689	Lime
		3689	T.D.

PLUGGING
 9. 11. 2044
 109 24

Set 219 feet of 10 inch surface pipe. Cemented with 100 sacks cement.

DRY, ABANDONED AND PLUGGED

C E R T I F I C A T E

I, C. C. Nelson, do hereby certify that the above and foregoing is a true and correct copy of log of the Fischer #1, Section 9-11S-20W, Ellis County, Kansas as reflected by files of the C. C. Nelson Drilling Company.

C. C. Nelson

Subscribed and sworn to before me a Notary Public, within and for Reno County, Kansas, this 29th day of February 1944.

Erna V. Sage

My Commission Expires March 25th, 1946.

3-1-1944