


Give All Information Completely
Make Required Affidavit
Mail or Deliver Report to:
Conservation Division
State Corporation Commission
800 Bitting Building
Wichita, Kansas

NORTH

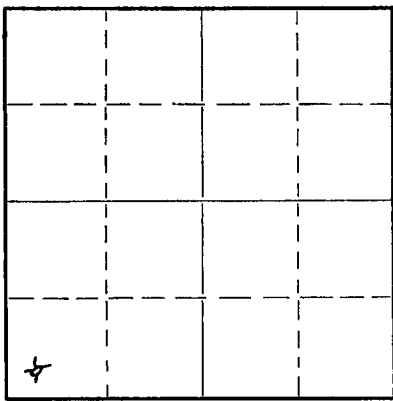

Locate well correctly on above
Section Plat

Ellice County. Sec. 13 Twp. 118 Rge. 20 (E) (W)
Location as "NE/CNW¹/₄SW¹/₄" or footage from lines SW SW SW
Lease Owner N. Appleman Company
Lease Name Baldwin Well No. 1
Office Address 120 Broadway, New York 5, New York
Character of Well (completed as Oil, Gas or Dry Hole) Dry Hole
Date well completed November 9 1949
Application for plugging filed November 9 1949
Application for plugging approved November 9 1949
Plugging commenced November 9 1949
Plugging completed November 9 1949
Reason for abandonment of well or producing formation Dry Hole

If a producing well is abandoned, date of last production 19
Was permission obtained from the Conservation Division or its agents before plugging was commenced? Yes

Name of Conservation Agent who supervised plugging of this well E. A. Fetty
Producing formation Depth to top Bottom Total Depth of Well 3710 Feet
Show depth and thickness of all water, oil and gas formations.

OIL, GAS OR WATER RECORDS

CASING RECORD

Formation	Content	From	To	Size	Put In	Pulled Out
		0	116'	13"	116'	None

Describe in detail the manner in which the well was plugged, indicating where the mud fluid was placed and the method or methods used in introducing it into the hole. If cement or other plugs were used, state the character of same and depth placed, from feet to feet for each plug set.

3710' - 116¹/₂' - Heavy Rotary Mud
 116¹/₂' - 115' - Wooden Plug
 115' - 82' - 25 sacks cement
 82' - 21¹/₂' - Heavy Rotary Mud
 21¹/₂' - 20' - Wooden Plug
 20 - Surface - 15 sacks cement

12-1-1949

(If additional description is necessary, use BACK of this sheet)


Correspondence regarding this well should be addressed to N. Appleman Company, 120 Broadway, New York 5, New York

STATE OF Kansas, COUNTY OF Barton, SS.
Glenn Peal Drilling Co., Inc. (employee of owner) or (OWNER) of the above-described well, being first duly sworn on oath: That I have knowledge of the facts, statements, and matters herein contained and the log of the above-described well as filed and that the same are true and correct. So help me God. GLENN PEAL DRILLING COMPANY, INC.
(Signature) NY: [Signature]
P.O. Box 159, Neisington, Kansas
(Address)

SUBSCRIBED AND SWORN to before me this 14th day of November, 1949.

[Signature] Notary Public.

My commission expires June 4, 1951

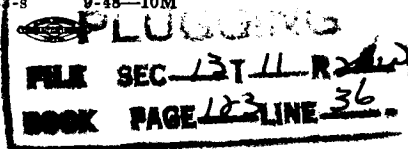

15-051-01088-00-00

WELLING'S LOG

Company: N. Appleman Company
Fuel-Burden Producers

Sec. 13 Twp. 11S Rge. 20W
SW SW SW

Well: Baldwin Well No. 1
Total Depth: 3720'

County: Ellis,
Kansas

Comm.: 10-29-49 Comp.: 11-9-49
Contractor: Glenn Fuel Drilling Co., Inc.
Casing: 13" 116' con.

Elevation:
Production: Dry

Figures below indicate bottom of formations

S-sd	0
Blue Shale	116
Shale and Shells	371
Shale and Sand	425
Sand	640
Shale	760
Sand and Shale Stracks	980
Shale and Sand	1230
Bedded	1380
Anhydrite	1415
Shale and Shells	1450
Shale and Lime	2030
Lime	2045
Lime and Shale	2370
Shale and Lime	2570
Lime and Shale	2770
Shale and Lime	2890
Lime and Shale	3042
S-sd	3051
Lime and Shale	3120
Lime	3270
Lime and Shale	3411
Conglomerate	3461
Arborescic Lime	3720
Total Depth	3720

This is to certify that the above information is, to the best of our knowledge, true and correct.

GLENN FUEL DRILLING COMPANY, INC.

By: J. B. Adams

SUBSCRIBED AND SWORN to before me this 14th day of November, 1949

My commission expires JUNE 4, 1951 Marion M. Hester

PLUGGING
FILE SEC 13 T 11S R 20W
BOOK PAGE 173 LINE 36

15-051-1049
1049