


WELL PLUGGING RECORD

Give All Information Completely  
Make Required Affidavit

COUNTY Trego SEC. 11 TWP. 11S RGE. 22W ~~XXW~~  
Location as in quarters or footage from lines:  
NW NW SE

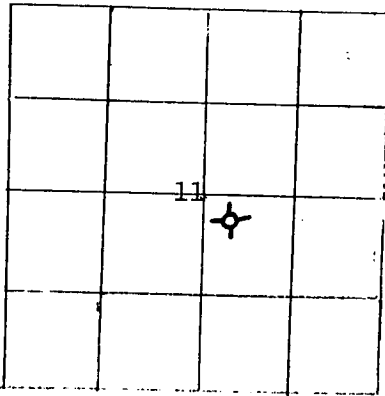

Lease Owner John O. Farmer, Inc.  
Lease Name Hillman "OWWO" Well No. #1  
Office Address P.O. Box 352, Russell, KS 67665  
Character of Well (Completed as Oil, Gas or Dry Hole): Dry Hole  
Date Well Completed May 19, 1982  
Application for plugging filed Yes  
Plugging commenced \_\_\_\_\_  
Plugging completed 4:15 A.M., 5-19-82  
Reason for abandonment of well or producing formation \_\_\_\_\_

Locate Well  
correctly on above  
Section Platt.

Was permission obtained from the Conservation Division or it's  
Agent's before plugging was commenced? Yes

Name of Conservation Agent who supervised plugging of this well Dennis Hamel  
Producing formation \_\_\_\_\_ Depth to top \_\_\_\_\_ bottom T.D.

Show depth and thickness of all water, oil and gas formations.

OIL, GAS OR WATER RECORDS

Casing Record

Formation	Content	From	To	Size	Put in	Pulled Out

Describe in detail the manner in which the well was plugged, indicating where the mud  
fluid was placed and the method or methods used in introducing it into the hold. If cement  
or other plugs were used, state the character of same and depth placed, from \_\_\_\_\_ feet  
to \_\_\_\_\_ feet for each plug set.

- Plug #1 @ 900' w/70 sxs. cement
- Plug #2 @ 230' w/40 sxs. cement
- Plug #3 @ 40' w/10 sxs. cement
- 10 sxs. cement in rathole

(If additional description is necessary, use BACK of this sheet)

Name of Plugging Contractor John O. Farmer, Inc.  
P.O. Box 352, Russell, KS 67665

STATE OF Kansas COUNTY OF Russell, ss.

John O. Farmer III (~~employee of owner~~) owner (owner or operator) of the  
above-described well, being first duly sworn on oath, says: That I have knowledge of the  
facts, statements, and matters herein contained and the log of the above-described well as  
filed and that the same are true and correct. So help me God.

(Signature) John O. Farmer III  
P.O. Box 352, Russell, KS 67665  
(Address)



SUBSCRIBED AND SWORN TO before me this 19th day of May, 19 82  
My Commission expires: January 27, 1985  
Margaret A. Schulte  
Notary Public.

RECEIVED  
STATE CORPORATION COMMISSION  
5-20-1982  
MAY 20 1982

CONSERVATION DIVISION  
Wichita, Kansas