

CARD MUST BE TYPED

State of Kansas
NOTICE OF INTENTION TO DRILL
(see rules on reverse side)

CARD MUST BE SIGNED

Starting Date: 1 17 86
month day year

3:31

API Number 15- 051-24395-00-00

OPERATOR: License # 6033

SE NW NE Sec 18. Twp 11. S, Rge 19. East West
(location)

Name Murfin Drilling Company

Address 250 N. Water, Suite 300

City/State/Zip Wichita, Ks. 67202

Contact Person David Doyel

Phone 316-267-3241

4290 Ft North from Southeast Corner of Section

1650 Ft West from Southeast Corner of Section

(Note: Locate well on Section Plat on reverse side)

CONTRACTOR: License # 6033

Name Murfin Drilling Company

City/State Wichita, Ks. 67202

Nearest lease or unit boundary line 990 feet.

County Ellis

Lease Name BERENS. Well# 1-18.

Domestic well within 330 feet: yes no

Municipal well within one mile: yes no

Well Drilled For: Well Class: Type Equipment:

- Oil Swd Infield Mud Rotary
- Gas Inj Pool Ext. Air Rotary
- OWWO Expl Wildcat Cable

Depth to Bottom of fresh water 110' feet

Lowest usable water formation ... Dakota

Depth to Bottom of usable water 700 feet

Surface pipe by Alternate: 1 2

Surface pipe to be set 300' feet

Conductor pipe if any required ----- feet

Ground surface elevation 2100 feet MSI.

This Authorization Expires 7-15-86

Approved By 1-15-86

If OWWO: old well info as follows:

Operator

Well Name

Comp Date Old Total Depth

Projected Total Depth 3700 feet

Projected Formation at TD Arbuckle

Expected Producing Formations Arbuckle

I certify that we will comply with K.S.A. 55-101, et seq., plus eventually plugging hole to K.C.C. specifications.

Date 1/15/86 Signature of Operator or Agent

David Doyel
David Doyel

Title Geologist


Must be filed with the K.C.C. five (5) days prior to commencing well
This card void if drilling not started within six (6) months of date received by K.C.C.

RECEIVED
STATE CORPORATION COMMISSION
1-15-1986
JAN 15 1986

Important procedures to follow:

A Regular Section of Land
1 Mile = 5,280 Ft.

CONSERVATION DIVISION Notify District office before setting surface casing.
Wichita, Kansas

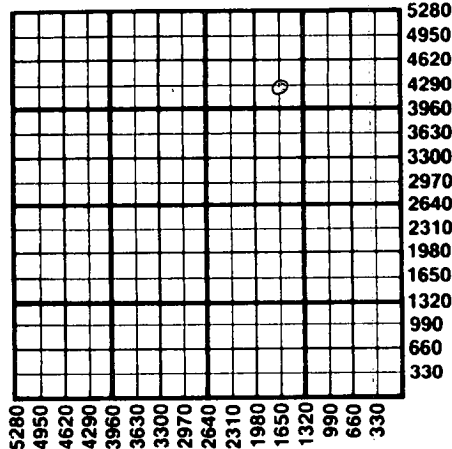

1. Notify District office before setting surface casing.
2. Set surface casing by circulating cement to the top.
3. File completion forms ACO-1 with K.C.C. within 90 days of well completion, following instructions on ACO-1, side 1, and including copies of wireline logs.
4. Notify District office 48 hours prior to old well workover or re-entry.
5. Prior to plugging, prepare a plugging plan, then obtain agreement from the appropriate district office for an approved plugging plan.
6. Submit plugging report (CP-4) to K.C.C. after plugging is completed.
7. Obtain an approved injection docket number before disposing of salt water.
8. Notify K.C.C. within 10 days when injection commences or terminates.
9. If an alternate 2 completion, cement in the production pipe from below any usable water to surface within 120 days of spud date.

State Corporation Commission of Kansas
Conservation Division,
200 Colorado Derby Building
Wichita, Kansas 67202
(316) 263-3238