

FOR KCC USE:

15-051-25011-00-00

FORM C-1 7/91
FORM MUST BE TYPED
FORM MUST BE SIGNED
ALL BLANKS MUST BE FILLED

EFFECTIVE DATE: 10-9-99

State of Kansas

DISTRICT # 4

NOTICE OF INTENTION TO DRILL

SGA? Yes No

Must be approved by the K.C.C. five (5) days prior to commencing well.

Spot 180° NE 150' W of S/2 NE East
NE SW NE Sec 19 Twp 11 S Rg 19W x West

Expected Spud Date 10 month 15 day 99 year

1800 feet from South / North line of Section
1470 feet from East / West line of Section

OPERATOR: License # 32511
Name: Imperial American Oil Corporation
Address: 10004 W 20th St N
City/State/Zip: Wichita KS 67212
Contact Person: Hal C. Porter
Phone: 316-773-3808

IS SECTION x REGULAR IRREGULAR?
(NOTE: Locate well on the Section Plat on Reverse Side)

County: Ellis
Lease Name: Marjorie H. Well #: 19-1
Field Name: Wildcat

CONTRACTOR: License #: 30606
Name: Murfin Drilling Company, Inc.

Is this a Prorated/Spaced Field? yes x no
Target Formation(s): LKC. Arbuckle

Nearest lease or unit boundary: 840'
Ground Surface Elevation: 1965 feet MSL

Well Drilled For: Well Class: Type Equipment:
x Oil Enh Rec Infield x Mud Rotary
Gas Storage Pool Ext Air Rotary
OWWO Disposal x Wildcat Cable
Seismic: # of Holes Other

Water well within one-quarter mile: yes x no
Public water supply well within one mile: yes x no

Depth to bottom of fresh water: 180'
Depth to bottom of usable water: 700' ~ 580' B/DAKOTA

Surface Pipe by Alternate: x 1 x 2
Length of Surface Pipe Planned to be set: 1320'

Length of Conductor pipe required: None
Projected Total Depth: 3650'

Formation at Total Depth: Arbuckle
Water Source for Drilling Operations: well farm pond x other

If OWWO: old well information as follows:
Operator:
Well Name:
Comp. Date: Old Total Depth
Directional, Deviated or Horizontal wellbore? yes x no
If yes, true vertical depth:
Bottom Hole Location:

Will Cores Be Taken? yes x no
If yes, proposed zone:

AFFIDAVIT

The undersigned hereby affirms that the drilling, completion and eventual plugging of this well will comply with K.S.A. 55-101, et. seq.

It is agreed that the following minimum requirements will be met:

1. Notify the appropriate district office prior to spudding of well;
2. A copy of the approved notice of intent to drill shall be posted on each drilling rig;
3. The minimum amount of surface pipe as specified below shall be set by circulating cement to the top; in all cases surface pipe shall be set through all unconsolidated materials plus a minimum of 20 feet into the underlying formation;
4. If the well is dry hole, an agreement between the operator and the district office on plug length and placement is necessary prior to plugging;
5. The appropriate district office will be notified before well is either plugged or production casing is cemented in;
6. IF AN ALTERNATE II COMPLETION, PRODUCTION PIPE SHALL BE CEMENTED FROM BELOW ANY USABLE WATER TO SURFACE WITHIN 120 DAYS OF SPUD DATE. IN ALL CASES, NOTIFY DISTRICT OFFICE PRIOR TO ANY CEMENTING.

I hereby certify that the statements made herein are true and to the best of my knowledge and belief.

Date: September 30, 1999 Signature of Operator or Agent: Title...President

FOR KCC USE:
 API # 15- 051-250110000
 Conductor pipe required NONE feet
 Minimum surface pipe required 600 feet per Alt. (1) x
 Approved by: JK 10-4-99
 This authorization expires: 4-4-2000
 (This authorization void if drilling not started within 6 months of effective date.)
 Spud date: Agent:

19
11
19W
RECEIVED
KANSAS CORP COMM
1999 OCT - 1 12:08
10-1-1999

- REMEMBER TO:
- File Drill Pit Application (form CDP-1) with Intent to Drill;
 - File Completion Form ACO-1 within 120 days of spud date;
 - File acreage attribution plat according to field proration orders;
 - Notify appropriate district office 48 hours prior to workover or re-entry;
 - Submit plugging report (CP-4) after plugging is completed;
 - Obtain written approval before disposing or injecting salt water.

Mail to: KCC - Conservation Division, 130 S. Market - Room 2078, Wichita, Kansas 67202.

IN ALL CASES PLOT THE INTENDED WELL ON THE PLAT BELOW

PLAT OF ACREAGE ATTRIBUTABLE TO A WELL IN A PRORATED OR SPACED FIELD

If the intended well is in a prorated or spaced field, please fully complete this side of the form. If the intended well is in a prorated or spaced field complete the plat below showing that the well will be properly located in relationship to other wells producing from the common source of supply. Please show all the wells within 1 mile of the boundaries of the proposed acreage attribution unit for gas wells and within 1/2 mile of the boundaries of the proposed acreage attribution unit for oil wells.

API NO. 15- _____

O P E R A T O R _____

LOCATION OF WELL: COUNTY _____



LEASE _____ feet from south/north line of section
 WELL NUMBER _____ feet from east/west line of section
 FIELD _____ SECTION _____ TWP _____ RG _____

NUMBER OF ACRES ATTRIBUTABLE TO WELL _____ IS SECTION _____ REGULAR or _____ IRREGULAR
 QTR/QTR/QTR OF ACREAGE _____ **IF SECTION IS IRREGULAR, LOCATE WELL FROM NEAREST CORNER BOUNDARY.**

Section corner used: _____ NE _____ NW _____ SE _____ SW

PLAT

(Show location of the well and shade attributable acreage for prorated or spaced wells.)
 (Show footage to the nearest lease or unit boundary line.)

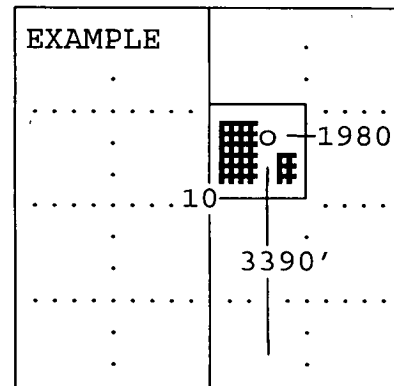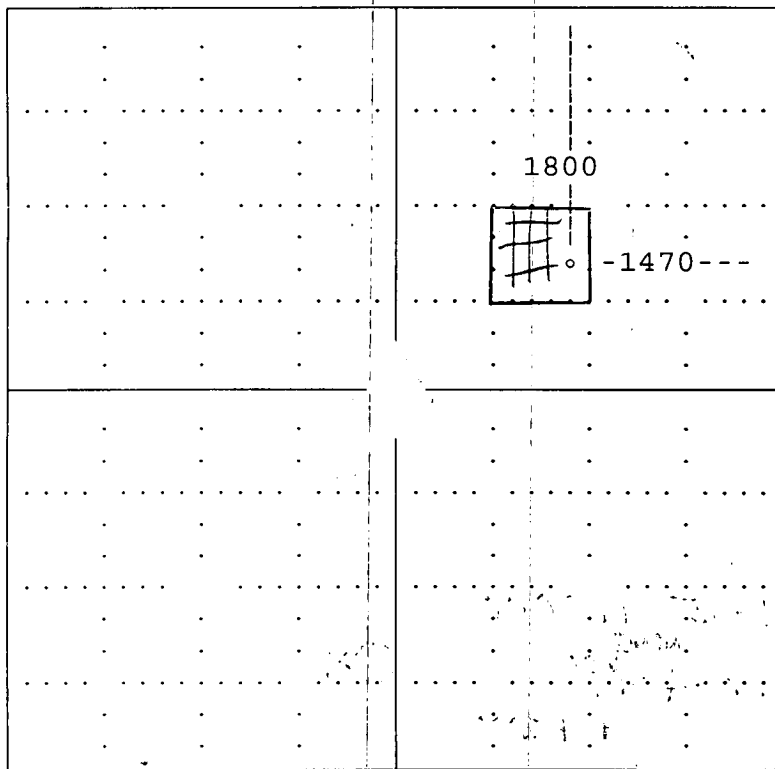

SEWARD CO.

In plotting the proposed location of the well, you must show:

- 1) The manner in which you are using the depicted plat by identifying section lines i.e. 1 section, 1 section with 8 surrounding sections, 4 sections, etc.;
- 2) the distance of the proposed drilling location from the section's south/north and east/west; and
- 3) the distance to the nearest lease or unit boundary line.

RECEIVED
 1999 OCT - 1 12:08