

CARD MUST BE TYPED

State of Kansas  
NOTICE OF INTENTION TO DRILL

CARD MUST BE SIGNED

(see rules on reverse side)

Starting Date: July 2, 1984  
month day year

API Number 15- 051-23,952-00-00

OPERATOR: License # 6033

C. E. / 2. W. / 2. SE Sec. 23. Twp. 11. S, Rge. 20.  East  West

Name Murfin Drilling Company

Address 250 N. Water Suite 300

City/State/Zip Wichita, Kansas 67202

Contact Person David Doyel

Phone 316- 267-3241

1320 Ft North from Southeast Corner of Section

1650 Ft West from Southeast Corner of Section

(Note: Locate well on Section Plat on reverse side)

CONTRACTOR: License # 6033

Name Murfin Drilling Company

City/State Wichita, Kansas 67202

Nearest lease or unit boundary line 1650 feet.

County Ellis

Lease Name Rusco-Davis Well# 1-23 B

Well Drilled For: Well Class: Type Equipment:

- Oil  Swd  Infield  Mud Rotary
- Gas  Inj  Pool Ext.  Air Rotary
- OWWO  Expl  Wildcat  Cable

Domestic well within 330 feet:  yes  no

Municipal well within one mile:  yes  no

If OWWO: old well info as follows:

Operator

Well Name

Comp Date Old Total Depth

Projected Total Depth 3690 feet

Projected Formation at TD Arbuckle

Expected Producing Formations Arbuckle

Depth to Bottom of fresh water ~~600~~ 70 feet

Lowest usable water formation Dakota

Depth to Bottom of usable water 800 feet

Surface pipe by Alternate: 1  2

Surface pipe to be set 220 feet

Conductor pipe if any required === feet

Ground surface elevation 2096 feet MSI

This Authorization Expires 12-28-84

Approved By E-2884

I certify that we will comply with K.S.A. 55-101, et seq., plus eventually plugging hole to K.C.C. specifications.

Date 6-28-84 Signature of Operator or Agent

DAVID DOYEL  
David Doyel

Title Geologist


MHC/KDHE 6-28-84

Must be filed with the K.C.C. five (5) days prior to commencing well  
This card void if drilling not started within six (6) months of date received by K.C.C.

RECEIVED  
STATE CORPORATION COMMISSION  
6-28-1984  
JUN 28 1984

**A Regular Section of Land**

1 Mile or 5280 Ft.

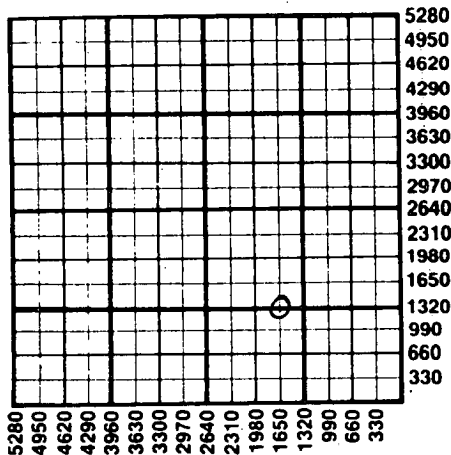

**Important procedures to follow:**

1. Notify District office before setting surface casing.
2. Set surface casing by circulating cement to the top.
3. File completion forms ACO-1 with K.C.C. within 90 days of well completion, following instructions on ACO-1, side 1, and including copies of wireline logs.
4. Notify District office 48 hours prior to old well workover or re-entry.
5. Prior to plugging, prepare a plugging plan, then obtain agreement from the appropriate district office for an approved plugging plan.
6. Submit plugging report (CP-4) to K.C.C. after plugging is completed.
7. Obtain an approved injection docket number before disposing of salt water.
8. Notify K.C.C. within 10 days when injection commences or terminates.
9. If an alternate 2 completion, cement in the production pipe from below any usable water to surface within 120 days of spud date.

State Corporation Commission of Kansas  
Conservation Division  
200 Colorado Derby Building  
Wichita, Kansas 67202  
(316) 263-3238