

CARD MUST BE TYPED

State of Kansas

CARD MUST BE SIGNED

NOTICE OF INTENTION TO DRILL

(see rules on reverse side)

Starting Date 12/15/86 month day year 11:29

API Number 15-051-24,453-00-00

OPERATOR: License # 6037 Name STAAB OIL CO. Address H.C. 39, Box 114 City/State/Zip Hays, Kansas 67601 Contact Person Francis Staab Phone 913-625-5013

NW NW NE Sec 28 Twp 11 S, Rg 20 X West 4950 Ft. from South Line of Section 2310 Ft. from East Line of Section

(Note: Locate well on Section Plat on reverse side)

CONTRACTOR: License # 5883 Name Warrior Drilling Co. Rig #1 City/State Wichita, Kansas

Nearest lease or unit boundary line 330 feet County ELLIS Lease Name KELLER Well # 1

Well Drilled For: Well Class: Type Equipment: X Oil SWD Infield X Mud Rotary Gas Inj Pool Ext Air Rotary OWWO Expl X Wildcat Cable

Ground surface elevation feet MSL Domestic well within 330 feet: yes X no Municipal well within one mile: yes X no Depth to bottom of fresh water 150 Depth to bottom of usable water 1000 Surface pipe by Alternate: 1 2 X Surface pipe planned to be set 250 Conductor pipe required none Projected Total Depth 3850 feet Formation Arbuckle

If OWWO: old well info as follows:

Operator Well Name Comp Date Old Total Depth

I certify that well will comply with K.S.A. 55-101, et seq., plus eventually plugging hole to KCC specifications.

Date 12-15-86 Signature of Operator or Agent Douglas W. Thimesch Title Vice President

For KCC Use:

Conductor Pipe Required 250 feet; Minimum Surface Pipe Required feet per Alt. 2

This Authorization Expires 6-15-87 Approved By 12-15-86


Handwritten signature

Must be filed with the K.C.C. five (5) days prior to commencing well
This card void if drilling not started within six (6) months of date received by K.C.C.

Important procedures to follow:

1. Notify District office before setting surface casing.
2. Set surface casing by circulating cement to the top.
3. File completion forms ACO-1 with K.C.C. within 90 days of well completion, following instructions on ACO-1, side 1, and including copies of wireline logs.
4. Notify District office 48 hours prior to old well workover or re-entry.
5. Prior to filing Intent, prepare a proposed plugging plan in case well is D & A, then obtain approval of plan when calling district office prior to setting surface pipe.
6. Submit plugging report (CP-4) to K.C.C. after plugging is completed.
7. Obtain an approved injection docket number before disposing of salt water.
8. Notify K.C.C. within 10 days when injection commences or terminates.
9. If an alternate 2 completion, cement in the production pipe from below any usable water to surface within 120 days of spud date.

**A Regular Section of Land
1 Mile = 5,280 Ft.**

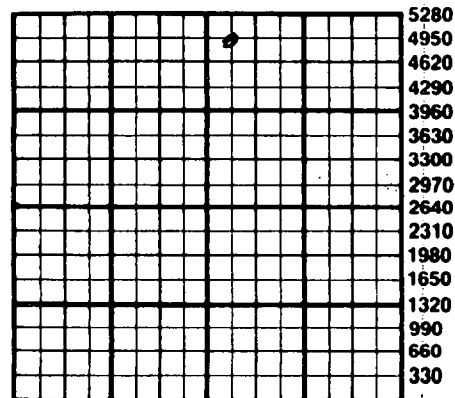

5280
4950
4620
4290
3960
3630
3300
2970
2640
2310
1980
1650
1320
990
660
330

RECEIVED
CORPORATION COMMISSION

DEC 15 1986
12-15-1986
CONSERVATION DIVISION
Wichita, Kansas

State Corporation Commission of Kansas
Conservation Division
200 Colorado Derby Building
Wichita, Kansas 67202
(316) 263-3238