

CARD MUST BE TYPED

State of Kansas
NOTICE OF INTENTION TO DRILL

CARD MUST BE SIGNED

(see rules on reverse side)

Starting Date: 6 25 85
month day year

API Number 15- **195-21,739-00-00**
NW SW SW Sec **7** Twp **11** S, Rge **21** East
(location) West

OPERATOR: License #
Name **Foxtire Exploration, Inc.**
Address **1022 Union Center**
City/State/Zip **Wichita, Kansas 67202**
Contact Person **D. C. Marchant/M. Starr**
Phone **1-(316)-265-6296**

..... 990 Ft North from Southeast Corner of Section
..... 4950 Ft West from Southeast Corner of Section
(Note: Locate well on Section Plat on reverse side)

CONTRACTOR: License # **8430**
Name **Foxtire Drilling Company**
City/State/Zip **P.O. Box 133, WaKeeney, KS 67672**

Nearest lease or unit boundary line 330 feet.
County **Trego**
Lease Name **Running W** Well# **1**

Well Drilled For: Well Class: Type Equipment:
 Oil Swd Infield Mud Rotary
 Gas Inj Pool Ext. Air Rotary
 OWWO Expl Wildcat Cable

Domestic well within 330 feet : yes no
Municipal well within one mile : yes no

If OWWO: old well info as follows:
Operator
Well Name
Comp Date Old Total Depth
Projected Total Depth **3850** feet
Projected Formation at TD **Penn. Cong.**
Expected Producing Formations **Marmaton (Pawnee)**

Depth to Bottom of fresh water 130 feet
Lowest usable water formation **Dakota**
Depth to Bottom of usable water **675 900** feet
Surface pipe by Alternate : 1 2
Surface pipe to be set 200 feet
Conductor pipe if any required **None** feet
Ground surface elevation **2160** feet MSL
This Authorization Expires **12-17-85**
Approved By **6-17-85** *PC*

I certify that we will comply with K.S.A. 55-101, et seq., plus eventually plugging hole to K.C.C. specifications.

Date **6-14-85** Signature of Operator or Agent


D. C. Marchant
D. C. Marchant Title

MHC/KOHE 6-17-85
Owner

Must be filed with the K.C.C. five (5) days prior to commencing well
 This card void if drilling not started within six (6) months of date received by K.C.C.

Important procedures to follow :

A Regular Section of Land
1 Mile = 5,280 Ft.

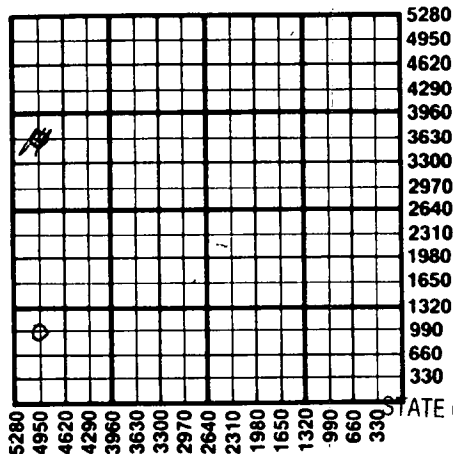

1. Notify District office before setting surface casing.
2. Set surface casing by circulating cement to the top.
3. File completion forms ACO-1 with K.C.C. within 90 days of well completion, following instructions on ACO-1, side 1, and including copies of wireline logs.
4. Notify District office 48 hours prior to old well workover or re-entry.
5. Prior to plugging, prepare a plugging plan, then obtain agreement from the appropriate district office for an approved plugging plan.
6. Submit plugging report (CP-4) to K.C.C. after plugging is completed.
7. Obtain an approved injection docket number before disposing of salt water.
8. Notify K.C.C. within 10 days when injection commences or terminates.
9. If an alternate 2 completion, cement in the production pipe from below any usable water to surface within 120 days of spud date.

RECEIVED
 STATE CORPORATION COMMISSION

6-17-1985
 JUN 17 1985

State Corporation Commission of Kansas
 Conservation Division
 200 Colorado Derby Building
 Wichita, Kansas 67202
 (316) 263-3238

CONSERVATION DIVISION
 Wichita, Kansas