

CARD MUST BE TYPED

State of Kansas
NOTICE OF INTENTION TO DRILL

CARD MUST BE SIGNED

(see rules on reverse side)

Starting Date: 10th 25 84
month day year

API Number 15- **195-21,617-00-00**

OPERATOR: License # 5141
Name ZENITH DRILLING CORPORATION
Address Suite 505 Fourth Financial Center
City/State/Zip Wichita, Kansas 67202
Contact Person Sherrill Compton
Phone (316) 265-6697

SE SW NW
(location) Sec 34 Twp 11 S, Rge 21 East West

CONTRACTOR: License # 5476
Name DNB Drilling, Inc.
City/State Wichita, Kansas

2970 Et North from Southeast Corner of Section
4290 Ft West from Southeast Corner of Section
(Note: Locate well on Section Plat on reverse side)

Well Drilled For: Well Class: Type Equipment:
 Oil Swd. Infield Mud Rotary
 Gas Inj. Pool Ext. Air Rotary
 OWWO Expl Wildcat Cable

Nearest lease or unit boundary line 330 feet.
County Trego
Lease Name Armbrister Well# 1
Domestic well within 330 feet: yes no
Municipal well within one mile: yes no

If OWWO: old well info as follows:
Operator
Well Name
Comp Date Old Total Depth
Projected Total Depth 4050 feet
Projected Formation at TD Arbuckle
Expected Producing Formations Lansing-Marmaton-Arbuckle

Depth to Bottom of fresh water 100 feet
Lowest usable water formation ~~Unknown~~ *Ds. Keta*
Depth to Bottom of usable water 1000 feet
Surface pipe by Alternate: 1 2
Surface pipe to be set 250 feet
Conductor pipe if any required None feet
Ground surface elevation 2310 feet MSL
This Authorization Expires **4-16-85**
Approved By **10-16-84** *RC*

I certify that we will comply with K.S.A. 55-101, et seq., plus eventually plugging hole to K.C.C. specifications.

Date 10/15/84
Signature of Operator or Agent


Sherrill Compton
Sherrill Compton Title Vice-President

MHC/KONE 10/16/84

Must be filed with the K.C.C. five (5) days prior to commencing well
This card void if drilling not started within six (6) months of date received by K.C.C.

Important procedures to follow:

A Regular Section of Land
1 Mile = 5,280 Ft.

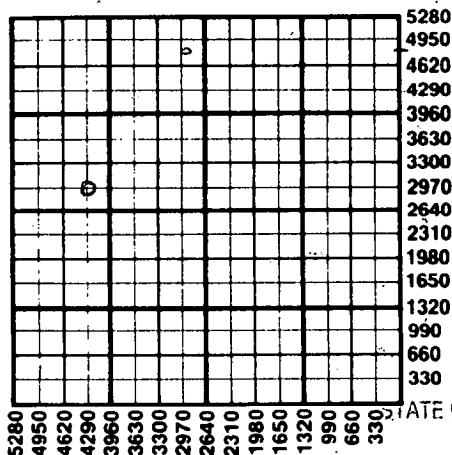

1. Notify District office before setting surface casing.
2. Set surface casing by circulating cement to the top.
3. File completion forms ACO-1 with K.C.C. within 90 days of well completion, following instructions on ACO-1, side 1, and including copies of wireline logs.
4. Notify District office 48 hours prior to old well workover or re-entry.
5. Prior to plugging, prepare a plugging plan, then obtain agreement from the appropriate district office for an approved plugging plan.
6. Submit plugging report (CP-4) to K.C.C. after plugging is completed.
7. Obtain an approved injection docket number before disposing of salt water.
8. Notify K.C.C. within 10 days when injection commences or terminates.
9. If an alternate 2 completion, cement in the production pipe from below any usable water to surface within 120 days of spud date.

RECEIVED
STATE CORPORATION COMMISSION

OCT 16 1984
10-16-1984
CONSERVATION DIVISION
Wichita, Kansas

State Corporation Commission of Kansas
Conservation Division
200 Colorado Derby Building
Wichita, Kansas 67202
(316) 263-3238